

Panola
T 9
5-21-70

MISSISSIPPI
BOARD OF WATER COMMISSIONERS
416 North State Street
Jackson, Mississippi 39201

CODED

WATER WELL DRILLERS LOG


5-21-1970 date well completed
70 James R. Lipe firm name
Panola county well located

LANDOWNER: John Wilkerson

description of formations encountered	from	to
Clay	0	20
SAND and clay	20	40
" " "	40	60
SAND	60	80
" "	80	100
" "	100	120
" "	120	143

Batesville Miss.
(mailing address)

WELL LOCATION:

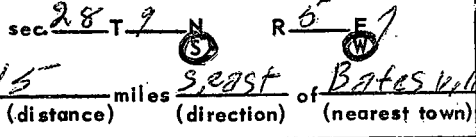

WELL PURPOSE: home
(home, irrigation, municipal, industrial)

WELL COMPLETION DATA:

- (1) diameter (inches) 4
- (2) total depth (feet) 143
- (3) static water level (feet) 40 below top of ground.
- (4) casing PVC 133 (material) (depth)
4" (size) if telescope see back.
- (5) screen 10 133 (length) (depth to top)
4" PVC (size) (material)
- (6) pump 3/4 10 (HP) (yield gpm)
E100 (type power)
- (7) electric log no (yes or no)
no (organization running log)
- (8) how well bottom plugged PVC Plug

CODED


JUL 10 1970

MISS. BD. OF WATER COMMISSIONERS

DRILLERS REMARKS: cut 8" rock at 92'

If well telescopes please sketch and show depths.

GROUND LEVEL

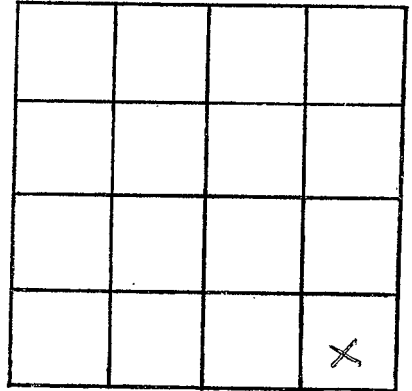

SECTION 28

Please indicate well location X.

ADDITIONAL INFORMATION

A series of horizontal lines for writing additional information.

If more than one screen, show locations of each on sketch.