

**MISSISSIPPI
BOARD OF WATER COMMISSIONERS**
416 North State Street
Jackson, Mississippi 39201

WATER WELL DRILLERS LOG **CODED**

Panola
T11
4-67

4-14 1967 Parkerson & Son Panola
date well completed firm name county well located

LANDOWNER: Mr. Royie Palmer

Description of formations encountered	from	to
	<u>Red clay</u>	<u>0</u>
<u>clay + sand</u>	<u>20</u>	<u>60</u>
<u>white sand</u>	<u>60</u>	<u>80</u>

Rt 1
Bataville, Miss
(mailing address)

WELL LOCATION:
sec. 33 T. 9 N R. 5 E
S W
15 1/2 miles SE of Bataville
(distance) (direction) (nearest town)


WELL PURPOSE: Home
(home, irrigation, municipal, industrial)

WELL COMPLETION DATA:

- (1) diameter (inches) 2 in
- (2) total depth (feet) 80
- (3) static water level (feet) 28 below above top of ground.
- (4) casing Plastic, 75,
(material) (depth)
2 in If telescope see back.
(size)
- (5) screen 5 ft, 75
(length) (depth to top)
3 in, gravel packed
(size) (material)
- (6) pump 1/4 HP 10
(HP) (yield gpm)
2 1/4 110
(type power)
- (7) electric log no
(yes or no)

(organization running log)
- (8) how well bottom plugged cased


CODED

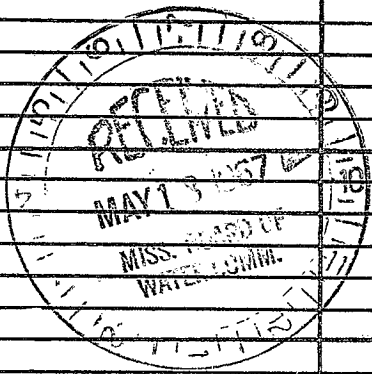

DRILLERS REMARKS: Plastic
Water Well

If well telescopes please sketch and show depths.

GROUND LEVEL

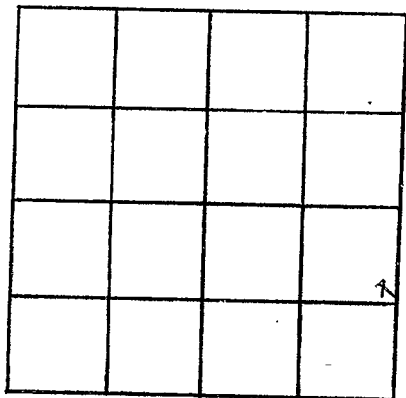

SECTION 33

Please indicate well location X.

ADDITIONAL INFORMATION

If more than one screen,
show locations of each on sketch.