

Panola
T12
1-68

MISSISSIPPI
 BOARD OF WATER COMMISSIONERS
 416 North State Street
 Jackson, Mississippi 39201

WATER WELL DRILLERS LOG

CODED

Jan 26 19*68* *Johnson & Son* *Panola*
 date well completed firm name county well located

LANDOWNER: *James Anderson*

description of formations encountered

Plot 1
Batesville, Miss
 (mailing address)

description of formations encountered	from	to
<i>sand & clay</i>	<i>0</i>	<i>40</i>
<i>blue clay</i>	<i>40</i>	<i>100</i>
<i>sand & blue clay</i>	<i>100</i>	<i>150</i>
<i>white sand</i>	<i>150</i>	<i>150</i>

WELL LOCATION:
 sec. *16* T. *9* N. R. *5* E
16 miles *SE* of *Batesville*
 (distance) (direction) (nearest town)


WELL PURPOSE: *home*
 (home, irrigation, municipal, industrial)

WELL COMPLETION DATA:

- (1) diameter (inches) *4"*
- (2) total depth (feet) *130*
- (3) static water level (feet) *120* below top of ground.
- (4) casing *Plastic, 175'* (material) (depth)
4" (size) if telescope see back.
- (5) screen *5 ft, 175'* (length) (depth to top)
6" (size) *gravel packed* (material)
- (6) pump *3/4* (HP) *24* (yield gpm)
EVA 220 (type power)
- (7) electric log *no* (yes or no)
 (organization running log)
- (8) how well bottom plugged *plugged*


CODED

DRILLERS REMARKS: *Plastic water well*

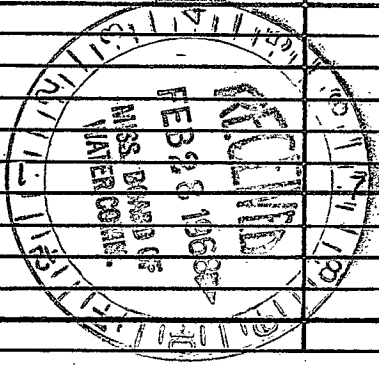

If well telescopes please sketch and show depths.

GROUND LEVEL

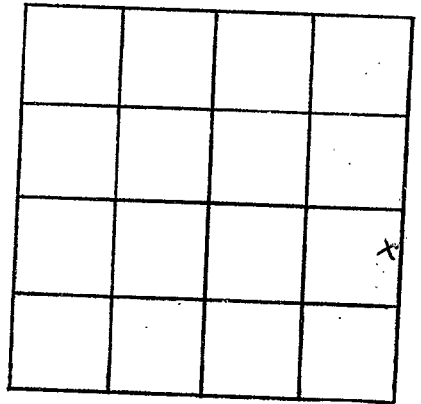

SECTION 16

Please indicate well location X.

ADDITIONAL INFORMATION

If more than one screen, show locations of each on sketch.