

Panola
T13
8-68

MISSISSIPPI
 BOARD OF WATER COMMISSIONERS
 416 North State Street
 Jackson, Mississippi 39201

CODED

WATER WELL DRILLERS LOG

8/5/ 1968 Bob Smith Panola
 date well completed firm name county well located

LANDOWNER: Taylor

description of formations encountered	from	to
<u>top soil</u>	<u>0</u>	<u>10</u>
<u>fine sand</u>	<u>10</u>	<u>40</u>
<u>coarse sand</u>	<u>40</u>	<u>140</u>

Batesville, Miss
 (mailing address)

WELL LOCATION:
 sec. 5 T 9 N R 5 E
8 miles west of Oxford
 (distance) (direction) (nearest town)

WELL PURPOSE: Home
 (home, irrigation, municipal, industrial)

WELL COMPLETION DATA:
 (1) diameter (inches) 4
 (2) total depth (feet) 140
 (3) static water level (feet) 60 below above top of ground.
 (4) casing plastic 140
 (material) (depth)

CODED


(size) If telescope see back.
 (5) screen 20 120
 (length) (depth to top)
4 plastic
 (size) (material)

(6) pump 1/3 10
 (HP) (yield gpm)
Gas
 (type power)

(7) electric log no
 (yes or no)

(organization running log)


(8) how well bottom plugged plugged

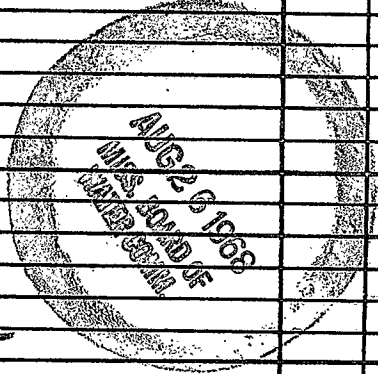

DRILLERS REMARKS:
good drilling

If well telescopes please sketch and show depths.

GROUND LEVEL

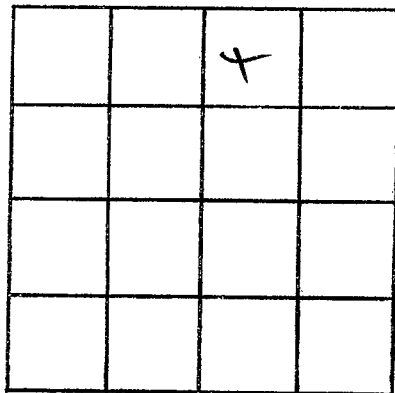

SECTION _____

Please indicate well location X.

ADDITIONAL INFORMATION

If more than one screen,
show locations of each on sketch.