

PANOLA
T 14
2-9-73

MISSISSIPPI
 BOARD OF WATER COMMISSIONERS
 416 North State Street
 Jackson, Mississippi 39201

CODED

WATER WELL DRILLERS LOG

2-9 1973 James R. Lipe Panola
 date well completed firm name county well located

LANDOWNER:
Thomas Palmatree
Batesville Miss.
 (mailing address)

description of formations encountered	from	to
<u>Top Soil</u>	<u>0</u>	<u>20</u>
<u>Clay</u>	<u>20</u>	<u>40</u>
<u>Clay</u>	<u>40</u>	<u>60</u>
<u>sand</u>	<u>60</u>	<u>80</u>
<u>Cl</u>	<u>80</u>	<u>100</u>
<u>Cl</u>	<u>100</u>	<u>120</u>
<u>Cl</u>	<u>120</u>	<u>147</u>

WELL LOCATION:
 sec. 20 T. 9 N. R. 6 E
 (distance) miles (direction) of (nearest town)
10 miles East of Batesville

WELL PURPOSE: HOME
 (home, irrigation, municipal, industrial)

- WELL COMPLETION DATA:
- (1) diameter (inches) 4
 - (2) total depth (feet) 147
 - (3) static water level (feet) 60 below above top of ground.
 - (4) casing PVC, 137
 (material) (depth)
4 if telescope see back.
 (size)
 - (5) screen 10', 137
 (length) (depth to top)
4 PVC
 (size) (material)
 - (6) pump 3/4 10
 (HP) (yield gpm)
Elec.
 (type power)
 - (7) electric log NO
 (yes or no)
NO
 (organization running log)
 - (8) how well bottom plugged PVC
PIUG


CODED

DRILLERS REMARKS:

APR 5 1973

If well telescopes please sketch and show depths.

GROUND LEVEL

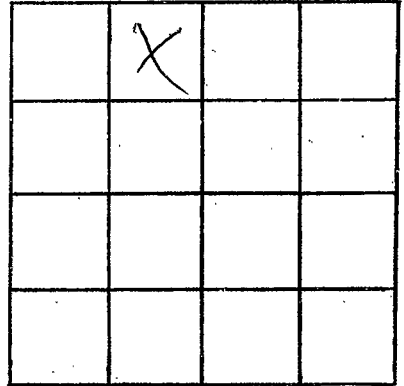

SECTION 20

Please indicate well location X.

ADDITIONAL INFORMATION

If more than one screen,
show locations of each on sketch.