

PANOLA
T 18
5-20-73

MISSISSIPPI
BOARD OF WATER COMMISSIONERS
416 North State Street
Jackson, Mississippi 39201

CODED

WATER WELL DRILLERS LOG

May 20 1973 J B Cain Panola
date well completed firm name county well located

LANDOWNER: Mr. H. Laforth

description of formations encountered	from	to
Clay + Sand Str.	0	160
Clay	160	200
Sand	200	220

(mailing address)

WELL LOCATION:

sec. 21 T 9 N R 6 E
12 miles E of Batesville
(distance) (direction) (nearest town)

WELL PURPOSE: Home
(home, irrigation, municipal, industrial)

CODED

WELL COMPLETION DATA:

- (1) diameter (inches) 4"
- (2) total depth (feet) 290
- (3) static water level (feet) 140 below top of ground.
- (4) casing Plastic 220 (material) (depth)
(size) if telescope see back.
- (5) screen 20, 250 (length) (depth to top)
4", Plastic (size) (material)
- (6) pump 2HP 36 (HP) (yield gpm)
Ela (type power)
- (7) electric log no (yes or no)

(organization running log)

(8) how well bottom plugged Plug


DRILLERS REMARKS:

SEP 21 1973

MISS. RD. & WATER COM.

If well telescopes please sketch and show depths.

GROUND LEVEL

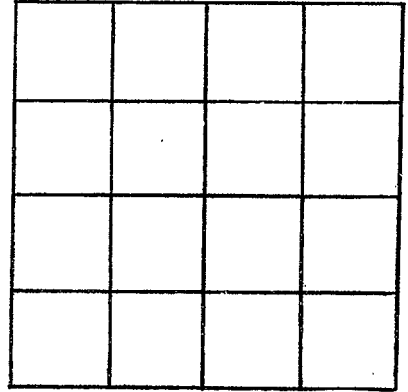

SECTION _____

Please indicate well location X.

ADDITIONAL INFORMATION

If more than one screen,
show locations of each on sketch.