

PANOLA
T 19
6-1-73

MISSISSIPPI
BOARD OF WATER COMMISSIONERS
416 North State Street
Jackson, Mississippi 39201

ALL
CODED

WATER WELL DRILLERS LOG

June 1 1973 J. B. Cain Panola
date well completed firm name county well located

LANDOWNER: James Henderson

Description of formations encountered from to

(mailing address)

Sand & Clay 0 150

WELL LOCATION:

sec. 28 T 9 N R 5 E
S 1/2 W 1/2
13 miles E of Batesville
(distance) (direction) (nearest town)

Sand 150 150

WELL PURPOSE: Home
(home, irrigation, municipal, industrial)

WELL COMPLETION DATA:

- (1) diameter (inches) 4"
- (2) total depth (feet) 130
- (3) static water level (feet) 150 below above top of ground.
- (4) casing Plastic 1 1/2', (material) (depth)
(size) if telescope see back.
- (5) screen 10', 170 (length) (depth to top)
4", Plastic (size) (material)
- (6) pump 3/4, 10 (HP) (yield gpm)
Edison (type power)
- (7) electric log No (yes or no)
(organization running log)
- (8) how well bottom plugged Plug

CODED


DRILLERS REMARKS:

SEP 27 1973

MISS. Bd. of
WATER CONTROL

If well telescopes please
sketch and show depths.

GROUND LEVEL

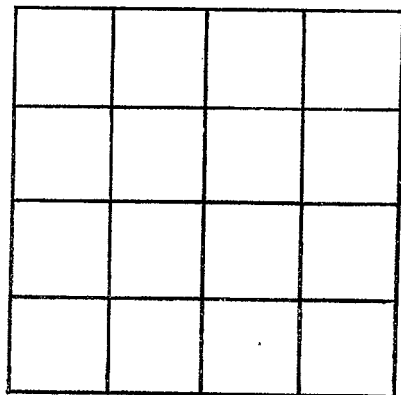

SECTION _____

Please indicate well location X.

ADDITIONAL INFORMATION

If more than one screen,
show locations of each on sketch.