

PANOLA

T 20

9-11-73

MISSISSIPPI BOARD OF WATER COMMISSIONERS
416 North State Street
Jackson, Mississippi 39201

CODED

WATER WELL DRILLERS LOG

9-11

19

JAMES B. LIPE

PANOLA

date well completed

firm name

county well located

LANDOWNER:

Wes Chapman
Batesville Miss.
(mailing address)

description of formations encountered

from to

Top Soil

0 20

Clay

20 40

White clay and sand

40 60

White sand

60 80

Clay

80 100

cc

100 120

Clay and sand

120 140

White sand

140 160

WELL LOCATION:

sec. 8 T 9 N R 5 E
15 miles east of Batesville
(distance) (direction) (nearest town)

WELL PURPOSE:

(home, irrigation, municipal, industrial)

WELL COMPLETION DATA:

- (1) diameter (inches) 4
- (2) total depth (feet) 160
- (3) static water level (feet) 120 below top of ground.
- (4) casing PVC 152 (material) (depth)
4 (size) if telescope see back.
- (5) screen 8 152 (length) (depth to top)
4 PVC (size) (material)
- (6) pump 3/4 10 (HP) (yield gpm)
elec. (type power)
- (7) electric log NO (yes or no)
NO (organization running log)
- (8) how well bottom plugged PVC Plug


CODED

DRILLERS REMARKS:

NET 9/19/73

If well telescopes please
sketch and show depths.

GROUND LEVEL

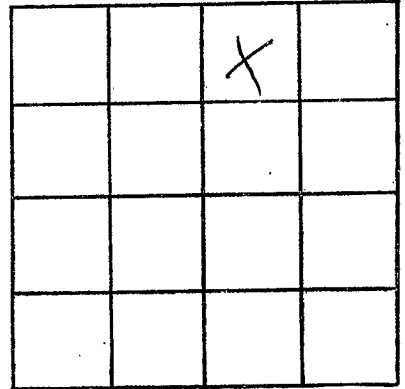

SECTION 8

Please indicate well location X.

ADDITIONAL INFORMATION

If more than one screen,
show locations of each on sketch.