

PANOLA
T 22
2-9-74

MISSISSIPPI
 BOARD OF WATER COMMISSIONERS
 416 North State Street
 Jackson, Mississippi 39201

CODED

WATER WELL DRILLERS LOG

2-9 1974 Life Well Co. Panola
 date well completed firm name county well located

LANDOWNER:
Eward Johnson
Batesville Miss.
 (mailing address)

description of formations encountered	from	to
TOP soil	0	20
Sand	20	40
" "	40	60
Clay	60	80
Sand and clay	80	100
SAND	100	143

WELL LOCATION:
 sec. 7 T 9 N R 5 E
7 miles EAST of Batesville
 (distance) (direction) (nearest town)

WELL PURPOSE:
 (home irrigation, municipal, industrial)

- WELL COMPLETION DATA:
- (1) diameter (inches) 4
 - (2) total depth (feet) 143
 - (3) static water level (feet) 85 below above top of ground.
 - (4) casing PVC 133
 (material) (depth)
4 if telescope see back.
 (size)
 - (5) screen 10 133
 (length) (depth to top)
4 PVC
 (size) (material)
 - (6) pump 3/4 10
 (HP) (yield gpm)
elec.
 (type power)
 - (7) electric log no
 (yes or no)
no
 (organization running log)
 - (8) how well bottom plugged PVC
plug

CODED


RECORDED
 MAR 5 1974

DRILLERS REMARKS:

MISS. BD. OF WATER COMM.

If well telescopes please sketch and show depths.

GROUND LEVEL

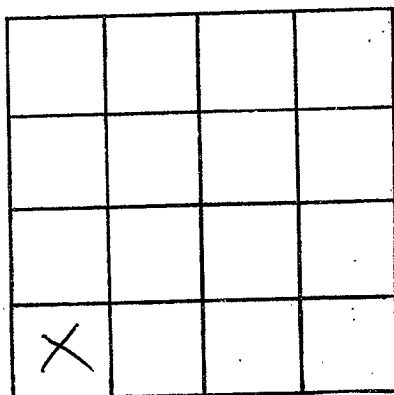

SECTION 2

Please indicate well location X.

ADDITIONAL INFORMATION

If more than one screen, show locations of each on sketch.