

PANOLA
 T 23
 S-13-74

MISSISSIPPI
 BOARD OF WATER COMMISSIONERS
 416 North State Street
 Jackson, Mississippi 39201

CODED

WATER WELL DRILLERS LOG

5-13 1974 Lipe Well Co. Panola
 date well completed firm name county well located

LANDOWNER:
 James Vaxter
 Batesville Miss.
 (mailing address)

description of formations encountered	from	to
Top soil	0	20
Sand	20	40
Clay	40	60
White sand	60	83

WELL LOCATION:
 sec. 8 T 9 N R 5 E
 11 miles S east of Batesville
 (distance) (direction) (nearest town)

WELL PURPOSE:
 (home) Irrigation, municipal, industrial

CODED


- WELL COMPLETION DATA:
- (1) diameter (inches) 4
 - (2) total depth (feet) 83
 - (3) static water level (feet) 20 below top of ground.
 - (4) casing PVC 73 (material) (depth)
 4 (size) if telescope see back.
 - (5) screen 10" 73 (length) (depth to top)
 4 PVC (size) (material)
 - (6) pump 3/4 10 (HP) (yield gpm)
 elec (type power)
 - (7) electric log NO (yes or no)
 NO (organization running log)
 - (8) how well bottom plugged PVC PIUG

DRILLERS REMARKS:

MIN - A 1974
 MISS. BD. OF WATER COMMISSIONERS

If well telescopes please sketch and show depths.

GROUND LEVEL

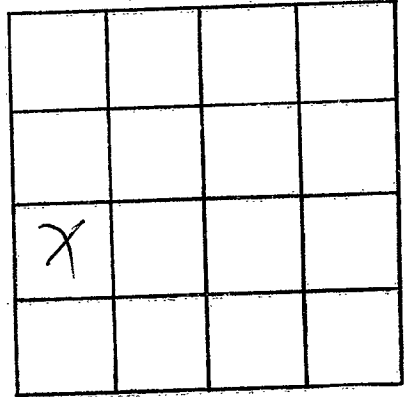

SECTION 8

Please indicate well location X.

ADDITIONAL INFORMATION

If more than one screen, show locations of each on sketch.