

PANOLA  
725  
10-12-74

MISSISSIPPI  
 BOARD OF WATER COMMISSIONERS  
 416 North State Street  
 Jackson, Mississippi 39201 CODED

WATER WELL DRILLERS LOG

10-12-1974 date well completed      W.A. Mason firm name      Panola county well located

LANDOWNER:	description of formations encountered	from	to
<u>Chie Tranel</u>	<u>clay det</u>	<u>0</u>	<u>18</u>
<u>RFD, Water Valley Miss.</u> (mailing address)	<u>gravel</u>	<u>18</u>	<u>30</u>
WELL LOCATION:	<u>white clay</u>	<u>30</u>	<u>100</u>
sec. <u>8</u> T. <u>9</u> N. R. <u>5</u> E.	<u>white sand</u>	<u>100</u>	<u>150</u>
<u>10</u> miles <u>west</u> of <u>Batesville</u>	<u>blue clay</u>	<u>at</u>	<u>150</u>
(distance) (direction) (nearest town)			
WELL PURPOSE: <u>Home</u> (home, irrigation, municipal, industrial)			
WELL COMPLETION DATA:			
(1) diameter (inches) <u>4</u>			
(2) total depth (feet) <u>150'</u>			
(3) static water level (feet) <u>100'</u> below top of ground.			
(4) casing <u>Plastic</u> , <u>140'</u> (material) (depth)			
<u>4"</u> If telescope see back. (size)			
(5) screen <u>10'</u> , <u>140'</u> (length) (depth to top)			
<u>4"</u> , <u>Plastic</u> (size) (material)			
(6) pump <u>1/3</u> , <u>5</u> (HP) (yield gpm)			
<u>electric</u> (type power)			
(7) electric log <u>No</u> (yes or no)			
(organization running log)			
(8) how well bottom plugged <u>Cap</u>			
DRILLERS REMARKS:			


CODED

RECEIVED  
 DEC 27 1974

MISS. BD OF WATER COMMISSIONERS

If well telescopes please sketch and show depths.

GROUND LEVEL

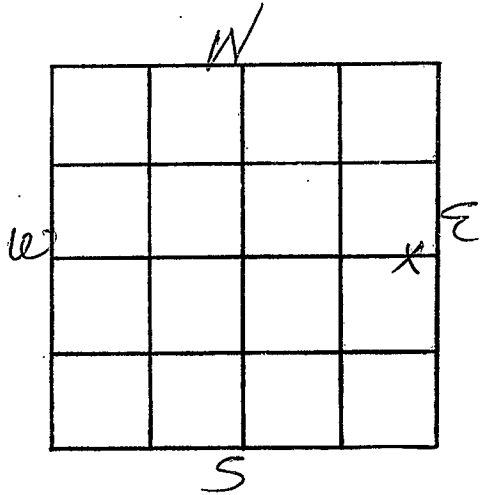

SECTION \_\_\_\_\_

Please indicate well location X.

ADDITIONAL INFORMATION

If more than one screen, show locations of each on sketch.