


PANOLA  
 T2C  
 7-31-74

MISSISSIPPI  
 BOARD OF WATER COMMISSIONERS  
 416 North State Street  
 Jackson, Mississippi 39201

WATER WELL DRILLERS LOG


CODED

7-31-1974 W.A. Mason Panola  
 date well completed firm name county well located

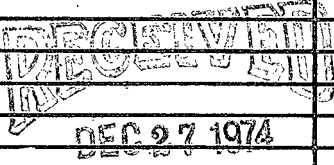LANDOWNER:	description of formations encountered	from	to
Dempsey Pierce Marks Miss. (mailing address)			
WELL LOCATION:	streaks of white sand & streaks of white clay	70	120
sec. 32 T 9 N R. 5 E 1 1/2 miles SE of Batesville (distance) (direction) (nearest town)			
WELL PURPOSE: Home (home, irrigation, municipal, industrial)	white sand	120	155
WELL COMPLETION DATA:	CODED		
(1) diameter (inches) 4"			
(2) total depth (feet) 155'			
(3) static water level (feet) 58 below top of ground.			
(4) casing Plastic, 145' (material) (depth) 4" if telescope see back. (size)			
(5) screen 10' 145' (length) (depth to top) 4" Plastic (size) (material)			
(6) pump 1/2 7 (HP) (yield gpm) electric (type power)			
(7) electric log No (yes or no) (organization running log)			
(8) how well bottom plugged Cap			
DRILLERS REMARKS:	MISS. RD. OF WATER COMMISSIONERS		

If well telescopes please sketch and show depths.

GROUND LEVEL

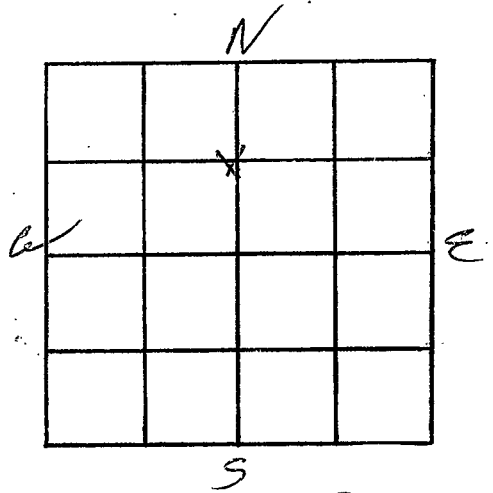

SECTION 32

Please indicate well location X.

ADDITIONAL INFORMATION

If more than one screen, show locations of each on sketch.