

PANOLA
T 27
S 10-74

MISSISSIPPI
BOARD OF WATER COMMISSIONERS
416 North State Street
Jackson, Mississippi 39201

CODED

WATER WELL DRILLERS LOG

5-10-74 1974 W.R. Mason Panola
date well completed firm name county well located

LANDOWNER:

James Wesley Thompson
RFD, Sardinia Miss
(mailing address)

description of formations encountered

from to

Clay Lint	8	8
Red sand	8	30
blue clay	30	40
gray sand	40	60
Blue clay	at	60

WELL LOCATION:

sec. 6 T 9 N R 5 E
9 miles East of Batavia
(distance) (direction) (nearest town)

WELL PURPOSE: Home
(home, irrigation, municipal, industrial)

WELL COMPLETION DATA:

- (1) diameter (inches) 4"
- (2) total depth (feet) 60'
- (3) static water level (feet) 18' below top of ground.
- (4) casing Plastic 40' (material) (depth)
4" (size) If telescope see back.
- (5) screen 20' 40' (length) (depth to top)
4" Plastic (size) (material)
- (6) pump 1/2 7 (HP) (yield gpm)
electric (type power)
- (7) electric log No (yes or no)

(organization running log)

(8) how well bottom plugged cap

CODED


RECEIVED
DEC 27 1974

DRILLERS REMARKS:

MISS. BD. OF WATER COMM

If well telescopes please sketch and show depths.

GROUND LEVEL

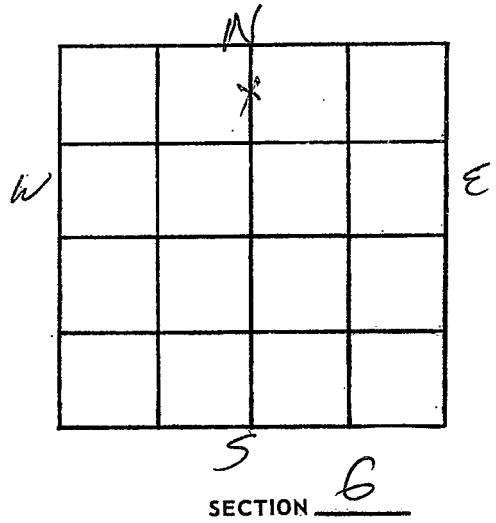

Please indicate well location X.

ADDITIONAL INFORMATION

If more than one screen,
show locations of each on sketch.