

PANOLA  
T-2000  
3-2-76

MISSISSIPPI  
BOARD OF WATER COMMISSIONERS  
416 North State Street  
Jackson, Mississippi 39201

WATER WELL DRILLERS LOG

3-2

1976 Life Well Co

Panola

date well completed

firm name

county well located


LANDOWNER: <u>Mahorney and Houston</u>	description of formations encountered	from	to
Const. Co. Memphis Tenn. (mailing address)	red clay	0	20
	red sand	20	40
	clay and sand	40	60
	sand	60	80
	clay	80	100
	clay and sand	100	120
white sand	120	190	
WELL LOCATION: sec. <u>8</u> T. <u>9</u> N. R. <u>0</u> E. <u>10</u> miles <u>East</u> of <u>Batesville</u> (distance) (direction) (nearest town)			
WELL PURPOSE: <u>Irrigation</u> (home, irrigation, municipal, industrial)			
WELL COMPLETION DATA:			
(1) diameter (inches) <u>4</u>			
(2) total depth (feet) <u>190</u>			
(3) static water level (feet) <u>80</u> below above top of ground.			
(4) casing <u>PVC</u> <u>180</u> (material) (depth)			
<u>4</u> If telescope see back. (size)			
(5) screen <u>10</u> <u>180</u> (length) (depth to top)			
<u>4</u> <u>PVC</u> (size) (material)			
(6) pump <u>3/4</u> <u>10</u> (HP) (yield gpm)			
<u>elec.</u> (type power)			
(7) electric log <u>no</u> (yes or no)			
<u>no</u> (organization running log)			
(8) how well bottom plugged <u>PVC</u> <u>cap</u>			
DRILLERS REMARKS:			

REGISTERED  
MAR 20 1976

MISS. BD. OF WATER COMMISSIONERS

If well telescopes please sketch and show depths.

GROUND LEVEL

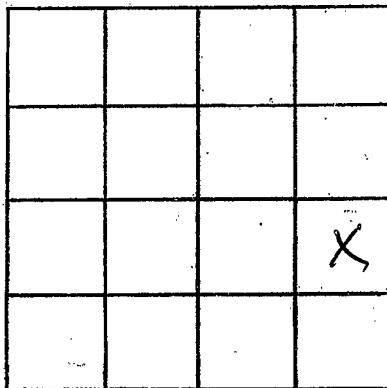

SECTION 8

Please indicate well location X.

ADDITIONAL INFORMATION

If more than one screen, show locations of each on sketch.