

PANOLA
 T-~~2001~~ 2001
 3/5/76

MISSISSIPPI
 BOARD OF WATER COMMISSIONERS
 416 North State Street
 Jackson, Mississippi 39201

WATER WELL DRILLERS LOG

3-6 1976
 date well completed

Big Strawn Well Drilling Co.
 J.B. Cairns
 firm name

PANOLA
 Lafayette
 county well located

LANDOWNER: Mr. Wg. Toles Rt. 1 Taylor, Miss.	description of formations encountered	from	to
(mailing address)	Sand	0	43
WELL LOCATION: sec. 19 T 9 N R 5 E Sv W ✓			
(distance) miles of (direction) (nearest town)			
WELL PURPOSE: home (home, irrigation, municipal, industrial)			
WELL COMPLETION DATA:			
(1) diameter (inches) 4"			
(2) total depth (feet) 49			
(3) static water level (feet) 30 below top of ground.			
(4) casing Plastic 49, (material) (depth)			
4" If telescope see back. (size)			
(5) screen 10, 23 (length) (depth to top)			
4" Plastic (size) (material)			
(6) pump 4 10 (HP) (yield gpm)			
Electric (type power)			
(7) electric log NO (yes or no)			
(organization running log)			
(8) how well bottom plugged Plugged			
DRILLERS REMARKS:			


RECEIVED
 DECEMBER 15 1976

APR 18 1976

MISSISSIPPI BOARD OF WATER COMMISSIONERS

If well telescopes please sketch and show depths.

GROUND LEVEL

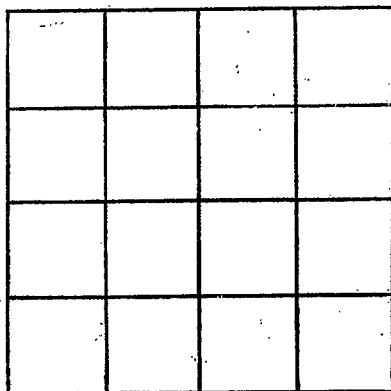

SECTION _____

Please indicate well location X.

ADDITIONAL INFORMATION

If more than one screen,
show locations of each on sketch.