

RECEIVED

PANOLA
T-2004
3-19-76

MISSISSIPPI
BOARD OF WATER COMMISSIONERS APR 21 1976
416 North State Street
Jackson, Mississippi 39201 MS. BD. OF WATER COMM.

WATER WELL DRILLERS LOG

3-19-76
date well completed

J. B. Cain
firm name

Panola
county well located

LANDOWNER: James Perkins

Rt 1 Batesville
Batesville, Miss.
(mailing address)

description of formations encountered

from to

| | | |
|------------|--------|--------|
| Clay | 0 | 14 |
| Sandy Clay | 14 | 49 |
| Rock | 49 | 50 1/2 |
| Blue Clay | 15 1/2 | 95 |
| Sand | 95 | 210 |

WELL LOCATION:

sec. 4 T 9 N R 5 E
12 miles E of Batesville
(distance) (direction) (nearest town)

WELL PURPOSE: Home
(home, irrigation, municipal, industrial)

WELL COMPLETION DATA:

- (1) diameter (inches) 4"
- (2) total depth (feet) 210
- (3) static water level (feet) 142 below top of ground.
- (4) casing Plastic, 210, (material) (depth)
- (size) If telescope see back.
- (5) screen 10' 200 (length) (depth to top)
- 4" Plastic (size) (material)
- (6) pump 3/4 12 (HP) (yield gpm)
- Flex (type power)
- (7) electric log NO (yes or no)


(organization running log)

(8) how well bottom plugged Wash Bottom

DRILLERS REMARKS:

If well telescopes please sketch and show depths.

GROUND LEVEL

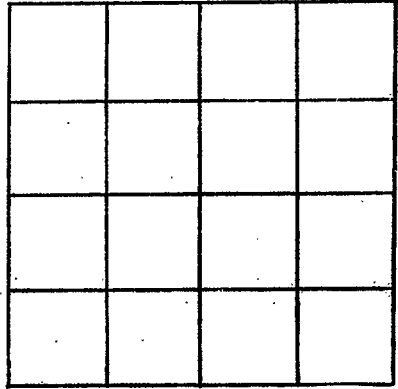

SECTION _____

Please indicate well location X.

ADDITIONAL INFORMATION

If more than one screen, show locations of each on sketch.