

PANOLA  
T 2003  
3-19-76

MISSISSIPPI  
 BOARD OF WATER COMMISSIONERS  
 416 North State Street  
 15F Jackson, Mississippi 39201

WATER WELL DRILLERS LOG

3-19 date well completed    1976 Lipe Well Co. firm name    Panola county well located

LANDOWNER:  
Mike Bay  
Batesville MS.  
 (mailing address)

description of formations encountered	from	to
TOP SOIL	0	20
red clay	20	40
red sand	40	60
course white sand	60	80
fine white sand	80	100
	100	120
	120	143

WELL LOCATION:  
 sec. 8 T 2 N R 5 E  
10 miles East of Batesville  
 (distance) (direction) (nearest town)

WELL PURPOSE:  
 (home) Irrigation, municipal, industrial

WELL COMPLETION DATA:

(1) diameter (inches) 4

(2) total depth (feet) 143

(3) static water level (feet) 90 below above top of ground.

(4) casing PVC, 133  
 (material) (depth)

4 If telescope see back.  
 (size)

(5) screen 10, 133  
 (length) (depth to top)

4, PVC  
 (size) (material)


(6) pump 3/4, 10  
 (HP) (yield gpm)

elec.  
 (type power)

(7) electric log no  
 (yes or no)

no  
 (organization running log)

(8) how well bottom plugged PVC  
cap

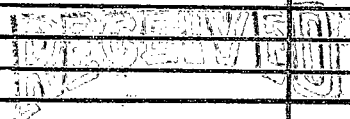


MAR 29 1976

DRILLERS REMARKS:

If well telescopes please sketch and show depths.

GROUND LEVEL

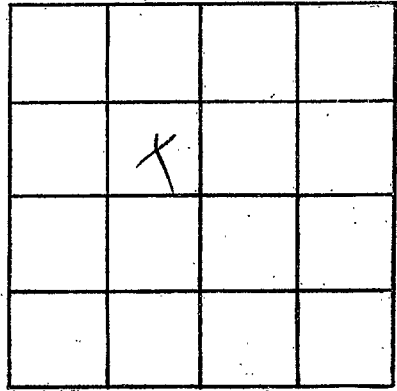

SECTION 8

Please indicate well location X.

ADDITIONAL INFORMATION

If more than one screen, show locations of each on sketch.