

PANOLA  
T-2004  
7-2-76

MISSISSIPPI  
 BOARD OF WATER COMMISSIONERS  
 416 North State Street  
 15F Jackson, Mississippi 39201

WATER WELL DRILLERS LOG

7-2 date well completed    1976 Lipe well Co. firm name    PANOLA county well located

LANDOWNER: Robert McKinney  
Batesville MS. (mailing address)

description of formations encountered	from	to
<u>Top soil</u>	<u>0</u>	<u>20</u>
<u>sand</u>	<u>20</u>	<u>40</u>
<u>Clay</u>	<u>40</u>	<u>80</u>
<u>ll</u>	<u>80</u>	<u>100</u>
<u>sand</u>	<u>100</u>	<u>120</u>

WELL LOCATION:  
 sec. 32 T 9 N R 5 E  
14 miles S.E. of Batesville  
 (distance) (direction) (nearest town)

WELL PURPOSE:  
 (home) irrigation, municipal, industrial


- WELL COMPLETION DATA:
- (1) diameter (inches) 4
  - (2) total depth (feet) 120
  - (3) static water level (feet) 55 below above top of ground.
  - (4) casing PVC 110  
 (material) (depth)  
4 If telescope see back.  
 (size)
  - (5) screen 10 110  
 (length) (depth to top)  
4 PVC  
 (size) (material)
  - (6) pump 3/4 10  
 (HP) (yield gpm)  
elac.  
 (type power)
  - (7) electric log NO  
 (yes or no)  
NO  
 (organization running log)
  - (8) how well bottom plugged \_\_\_\_\_

DRILLERS REMARKS:

**RECEIVED**  
 JUL - 7 1976  
 MISS. Bd. OF WATER COMMISSIONERS

If well telescopes please sketch and show depths.

GROUND LEVEL

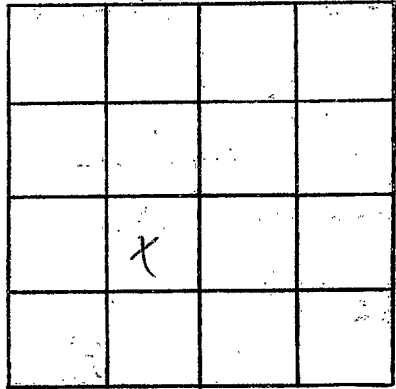

SECTION 32

Please indicate well location X.

ADDITIONAL INFORMATION

If more than one screen, show locations of each on sketch.