

PANOLA
T-2008
6-7-77

MISSISSIPPI
BOARD OF WATER COMMISSIONERS
416 North State Street
Jackson, Mississippi 39201

WATER WELL DRILLERS LOG

6-7
date well completed

1977 Lipe well Co.
firm name

Panola
county well located


LANDOWNER:	description of formations encountered	from	to
George Price			
Batesville Ms. (mailing address)	sand	20	100
	clay	100	130
	sand	130	163
WELL LOCATION:			
sec. 29 T. 9 N. R. 5 E. S W			
12 miles East of Pope (distance) (direction) (nearest town)			
WELL PURPOSE: (home, irrigation, municipal, industrial)			
WELL COMPLETION DATA:			
(1) diameter (inches) 4			
(2) total depth (feet) 163			
(3) static water level (feet) 110 below top of ground.			
(4) casing PVC 153 (material) (depth)			
4 If telescope see back. (size)			
(5) screen 10 156 (length) (depth to top)			
4 PVC (size) (material)			
(6) pump 3/4 10 (HP) (yield gpm)			
elec. (type power)			
(7) electric log NO (yes or no)			
NO (organization running log)			
(8) how well bottom plugged PVC PI 49			
DRILLERS REMARKS: cut rock at 100'			

RECEIVED

JUL 8 - 1977

If well telescopes please sketch and show depths.

GROUND LEVEL

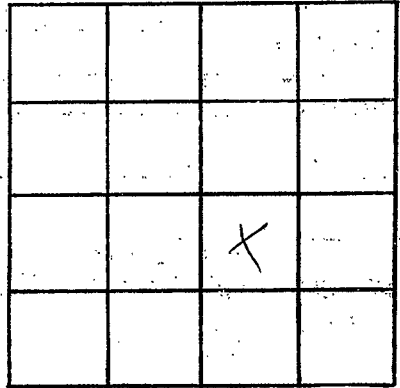

SECTION 29

Please indicate well location X.

ADDITIONAL INFORMATION

If more than one screen, show locations of each on sketch.