

MISSISSIPPI

BOARD OF WATER COMMISSIONERS

416 North State Street

Jackson, Mississippi 39201

WATER WELL DRILLERS LOG

Parola
T-2009

May 25 1984 *Lipell Well Supply* *Parola*
date well completed firm name county well located

LANDOWNER: *Evelyn Schuman*
RT 4 Box 57A
Patuxent MS.
(mailing address)

description of formations encountered	from	to
<i>Clay</i>	<i>0</i>	<i>10</i>
<i>Sand</i>	<i>10</i>	<i>40</i>
<i>Shale</i>	<i>40</i>	<i>45</i>
<i>Block Clay</i>	<i>45</i>	<i>100</i>
<i>Sand</i>	<i>100</i>	<i>100</i>

WELL LOCATION:
sec. *9* T. *9* N. R. *5* E
12 miles *East* of *Patuxent*
(distance) (direction) (nearest town)

WELL PURPOSE: *None*
(home, irrigation, municipal, industrial)

- WELL COMPLETION DATA:
- (1) diameter (inches) *4*
 - (2) total depth (feet) *100*
 - (3) static water level (feet) *80* (below above top of ground.)
 - (4) casing *PVC* *172*
(material) (depth)
4 if telescope see back.
(size)
 - (5) screen *8* *172*
(length) (depth to top)
4 *PVC*
(size) (material)
 - (6) pump *3/4* *10*
(HP) (yield gpm)
elec
(type power)
 - (7) electric log *NO*
(yes or no)

(organization running log)
 - (8) how well bottom plugged *PVC*
cap


DRILLERS REMARKS:

DEPT. OF NATURAL RESOURCES
BUREAU OF LAND & WATER RESOURCES

JUN 11 1984
RECEIVED

If well telescopes please sketch and show depths.

GROUND LEVEL

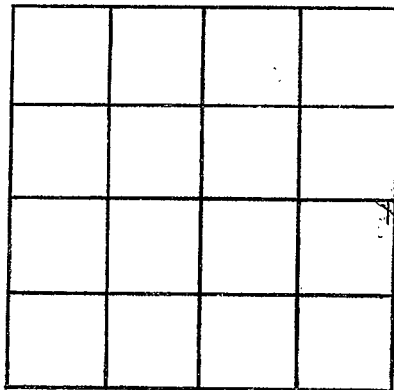

SECTION 9

Please indicate well location X.

ADDITIONAL INFORMATION

If more than one screen,
show locations of each on sketch.