

MISSISSIPPI DEPARTMENT OF NATURAL RESOURCES

Bureau of Land and Water Resources

Southport Mall

P.O. Box 10631

Jackson, Mississippi 39209

WATER WELL DRILLERS LOG

Panola
T2008

7-29-91 19 Lipay Well + Supply Panola
date well completed firm name county well located

LANDOWNER: Glenn Butler
Rt. 1 Box 79
Batesville, MS 38606
(mailing address)

WELL LOCATION:
sec 32 T 9 N R 5 E
8 miles (distance) SW (direction) of Batesville (nearest town)

WELL PURPOSE:
(home, irrigation, municipal, industrial)


WELL COMPLETION DATA:

- (1) diameter (inches) 4"
- (2) total depth (feet) 170'
- (3) static water level (feet) _____ below above top of ground.
- (4) casing PVC 160'
(material) (depth)
4 (size) if telescope see back.
- (5) screen 10' 160'
(length) (depth to top)
4 (size) PVC (material)
- (6) pump 3/4 F.W.
(HP) (yield gpm)

(type power)
- (7) electric log no
(yes or no)

(organization running log)
- (8) how well bottom plugged Capped

description of formations encountered	from	to
Top Soil then sand at bottom	1	20
Sand then gravel	20	40
Sand with shell rock about 42'	40	60
Yellow sand with a rock about 70'	60	80
Sand Clay with a rock about 96'	80	100
Clay	100	120
Clay	120	140
Clay then about 10' sand	140	160
Sand becoming streak	160	170

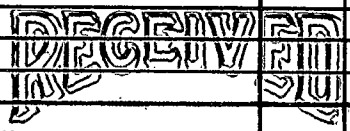


AUG 14 1991

Dept. of Environmental Quality
Bureau of Land & Water Resources

DRILLERS REMARKS:

If well telescopes please
sketch and show depths.

GROUND LEVEL

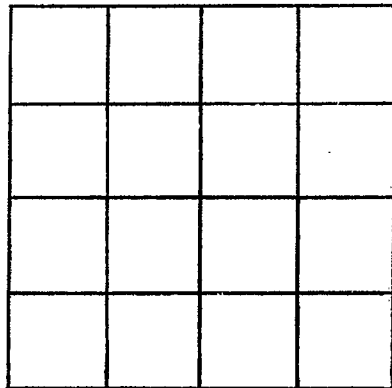

SECTION _____

Please indicate well location X.

ADDITIONAL INFORMATION

If more than one screen,
show locations of each on sketch.