

U

WATER WELL DRILLERS LOG

10-8-61

Date: 10-8, 1961, Driller: J B Cain County Panola  
 (Name)

(1) Owner of Land: <u>M L Newson</u> (Name)	Description & Color of Materials Sand, Clay, Red Clay, Shell, etc.	Thick- ness Feet	Depth Feet
<u>BATESVILLE MISS</u> (Address)	<u>Brk of Sand</u>	<u>10</u>	<u>15</u>
(2) Location: <u>1/4</u> , <u>1/4</u> , Sec. <u>   </u> T. <u>   </u> R. <u>   </u> <u>4</u> miles <u>North</u> of <u>Crowder</u> (distance) (direction) (Nearest Town)			
(3) Topography: <u>   </u> (Hilly) (Flat) (Level)			
(4) Purpose of Well: <u>for Stock</u> (Domestic Irrigation Municipal, Industrial, Other)			


Information upon completion of well:

- (1) Diameter 2 inches.
- (2) Total Depth 70 feet.
- (3) Water Level 12 feet below top of ground.
- (4) Cased to 70, Size 2 in.
- (5) Screen: Size 1/4, Length 6 FT.
- (6) Were any formations sealed against pollution?  
    yes,     no.

If YES depth of formation    

Why    

Drillers Remarks:    

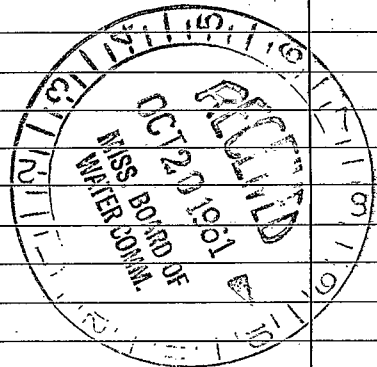

(Use Back Side)

Well No. 3

