

PANOLA MISSISSIPPI BOARD OF WATER COMMISSIONERS

U
2-25-64

WATER WELL DRILLERS LOG

Date: 2-25, 1965, Driller: J B Cain County Panola
(Name)

(1) Owner of Land: Honey Ware
(Name)
Crowder Miss
(Address)

Description & Color of Materials
Sand, Clay, Red Clay, Shell, etc.

Thickness Feet	Depth Feet
0	250
250	370
370	490

Sand
Blue Cl
Sand

(2) Location: 1/4, 1/4, Sec. T R
3 miles E of Crowder
(distance) (direction) (Nearest Town)

(3) Topography: (Hilly) (Flat) (Level)

(4) Purpose of Well: Home
(Domestic Irrigation
Municipal, Industrial, Other)

Information upon completion of well:

(1) Diameter 2 inches.

(2) Total Depth 490 feet.

(3) Water Level flow feet below top of ground.

(4) Cased to 420, Size 2"


(5) Screen: Size None, Length

(6) Were any formations sealed against pollution?
yes, no.

If YES depth of formation

Why

Drillers Remarks:

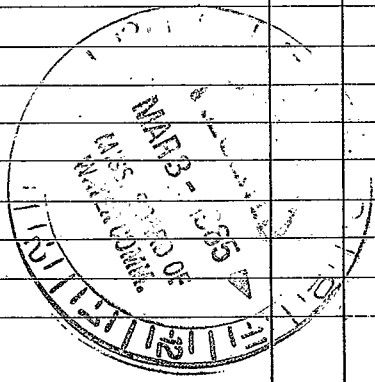

(Use Back Side)

Well No.

