

PANOLA

MISSISSIPPI BOARD OF WATER COMMISSIONERS

U

2-25-65

WATER WELL DRILLERS LOG

Date: 2-25, 1965, Driller: J B Cain County Panola

(Name)

(1) Owner of Land:	Description & Color of Materials Sand, Clay, Red Clay, Shell, etc.	Thick- ness Feet	Depth Feet
Henry Mares <small>(Name)</small> Crowder Miss <small>(Address)</small>	Sand Blue Sand	0 250 370	250 370 490
(2) Location: $\frac{1}{4}$, $\frac{1}{4}$, Sec. T. R.			
3 miles E of Crowder <small>(distance) (direction) (Nearest Town)</small>			
(3) Topography: <input checked="" type="checkbox"/> (Hilly) <input type="checkbox"/> (Flat) <input type="checkbox"/> (Level)			
(4) Purpose of Well: Home <small>(Domestic Irrigation Municipal, Industrial, Other)</small>			


Information upon completion of well:

- (1) Diameter 2 inches.
- (2) Total Depth 490 feet.
- (3) Water Level 270 feet below top of ground.
- (4) Cased to 420, Size 2 1/2
- (5) Screen: Size None Length _____
- (6) Were any formations sealed against pollution?
_____ yes, _____ no.

If YES depth of formation _____

Why _____

Drillers Remarks: _____

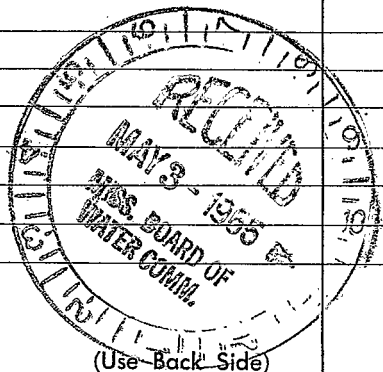

Well No.

