

PANOLA MISSISSIPPI BOARD OF WATER COMMISSIONERS

U
9-65

WATER WELL DRILLERS LOG

Date: _____, 1965, Driller: George Robinson County Panola
(Name)

(1) Owner of Land: Mr. Jay Doby
(Name)
Crowder, Miss
(Address)

(2) Location: 2 $\frac{1}{4}$, _____ $\frac{1}{4}$, Sec. _____ T _____ R _____
3 miles N of Crowder,
(distance) (direction) (Nearest Town)

(3) Topography: _____
(Hilly) (Flat) (Level) L

(4) Purpose of Well: Home
(Domestic Irrigation
Municipal, Industrial, Other)

Information upon completion of well:

(1) Diameter 2 inches.

(2) Total Depth 500 feet.

(3) Water Level flowing feet below top of ground.

(4) Cased to 400, Size 2in


(5) Screen: Size open, Length _____
bottom

(6) Were any formations sealed against pollution?
_____ yes, _____ no.

If YES depth of formation _____
Why _____

Drillers Remarks: Steel well

Description & Color of Materials Sand, Clay, Red Clay, Shell, etc.	Thick- ness Feet	Depth Feet
<u>Clay</u>	<u>0</u>	<u>20</u>
<u>Sand</u>	<u>20</u>	<u>80</u>
<u>sand + clay</u>	<u>80</u>	<u>300</u>
<u>sand</u>	<u>300</u>	<u>500</u>

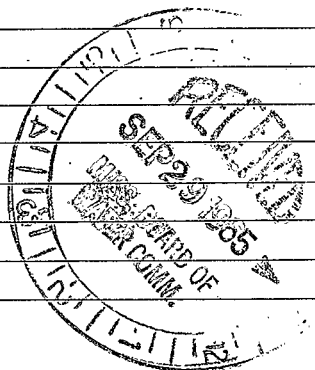

(Use Back Side)

Well No.

