

U

9-14-65

WATER WELL DRILLERS LOG

Date: 9-14, 1965, Driller: Garry Roberson County Panola (Name)


(1) Owner of Land: Mrs. Bailey (Name) Crowder, Miss (Address) (2) Location: 1/4, 1/4, Sec. T R, miles of Crowder, (distance) (direction) (Nearest Town) (3) Topography: (Hilly) (Flat) (Level) (4) Purpose of Well: Same (Domestic Irrigation Municipal, Industrial, Other)

Table with 3 columns: Description & Color of Materials, Thickness Feet, Depth Feet. Rows include Clay, Sand, Gravel, Sand, Sand & Clay, Sand, Clay, Sand.

Information upon completion of well:

(1) Diameter 2 inches. (2) Total Depth 820 feet. (3) Water Level flowing, feet below top of ground. (4) Cased to 420, Size 2 in. (5) Screen: Size Open, Length bottom. (6) Were any formations sealed against pollution? yes, no.

If YES depth of formation. Why. Drillers Remarks: Steel well

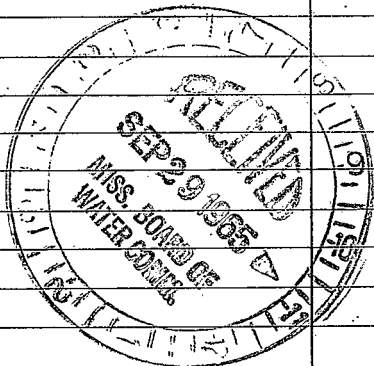

(Use Back Side)

Well No.

