

U3  
8-16-60

WATER WELL DRILLERS LOG ?

Date: 8-16, 1960; Driller: James L. Casey County PANOLA

(Name)

(1) Owner of Land: James L. Casey  
(Name)

COURTHAND RTE 70  
(Address)

(2) Location: 1/4, 1/4, Sec. 8 T. 2720 R. 12

6 miles W, of Portland  
(distance) (direction) (Nearest Town)

(3) Topography:  (Hilly)  (Flat)  (Level)

(4) Purpose of Well: Dom  
(Domestic Irrigation, Municipal, Industrial, Other)

Description & Color of Materials Sand, Clay, Red Clay, Shell, etc.	Thick- ness Feet	Depth Feet
<u>Top clay</u>	<u>20</u>	<u>20</u>
<u>light clay</u>	<u>30</u>	<u>50</u>
<u>limonite</u>	<u>50</u>	<u>100</u>
<u>light sand clay</u>	<u>40</u>	<u>140</u>
<u>clay</u>	<u>50</u>	<u>190</u>
<u>clay</u>	<u>30</u>	<u>220</u>
<u>sand</u>	<u>5</u>	<u>225</u>

Information upon completion of well:

(1) Diameter 2 inches.

(2) Total Depth 225 feet.

(3) Water Level 175 feet below top of ground.

(4) Cased to 210, Size 2


(5) Screen: Size 1/4, Length 6

(6) Were any formations sealed against pollution?  
no

If YES depth of formation \_\_\_\_\_

Why \_\_\_\_\_

Drillers Remarks: \_\_\_\_\_

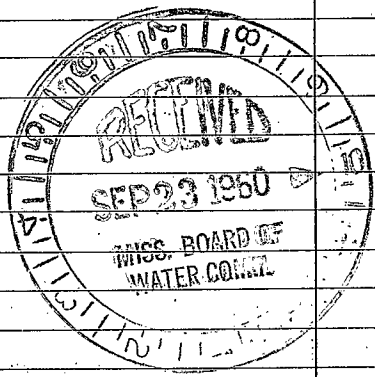

(Use Back Side)

Well No.

