

CODED

PANOLA

R U 4

WATER WELL DRILLERS LOG

6-14-61

Date: 6/14, 19 61 Driller: Jas R. Lipe County Panola

(1) Owner of Land: Heppack Murphy

Batesville (Address), Miss.

(2) Location: 1/4, 1/4, Sec. 23 T. 27 N. R. 2 E

9 miles West, of Pope (distance) (direction) (Nearest Town)

(3) Topography: (Hilly) Hilly (Level)

(4) Purpose of Well: Domestic Irrigation Municipal, Industrial, Other

Description & Color of Materials Sand, Clay, Red Clay, Shell, etc.	Thick- ness Feet	Depth Feet
Clay	0	20
gravel	20	40
black clay	40	50
Clay & Sand	50	70
Sand	70	100
refining sand	100	115

Information upon completion of well:

(1) Diameter 2 inches.

(2) Total Depth 115 feet.

(3) Water Level 96 feet below top of ground.

(4) Cased to 108' Size 2

(5) Screen: Size 1 1/4" Length 6'


(6) Were any formations sealed against pollution?

yes,  no.

If YES depth of formation

Why

Drillers Remarks:

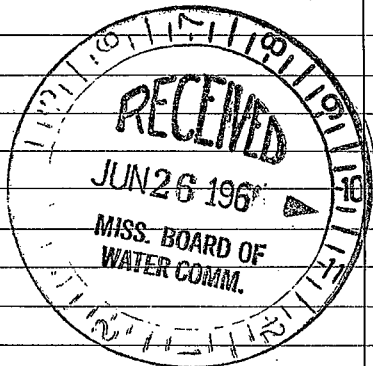

Well No.

(Use Back Side)

