

PANOLA WATER WELL DRILLERS LOG

CODED



Date: 6/27-6/30 1961 Driller: Geo. R. Lipe County: Denata
(Name)

(1) Owner of Land: Wm. Darby
(Name)
Batesville, Miss.
(Address)

(2) Location: 1/4, 1/4, Sec. 17 T. 27 N. R. 2 E
10 miles West of Pepe
(distance) (direction) (Nearest Town)

(3) Topography: Hilly
(Hilly) (Flat) (Level)

(4) Purpose of Well: Domestic
(Domestic Irrigation) (Municipal, Industrial, Other)

Description & Color of Materials Sand, Clay, Red Clay, Shell, etc.	Thickness Feet	Depth Feet
Clay	0	50
Clay & gravel	50	100
gravel & sand	100	155
red clay & sh.	155	150
rocky sand	150	175
gravel	175	200
fine gravel	200	236
sand & gravel	230	250
sand	250	275
pebbly sand	275	279

Information upon completion of well:

(1) Diameter 2 inches.

(2) Total Depth 279 feet.

(3) Water Level 275 feet below top of ground.

(4) Cased to 272 Size 2


(5) Screen: Size 1 1/4 Length 6'

(6) Were any formations sealed against pollution?
no.

If YES depth of formation _____

Why _____

Drillers Remarks: _____

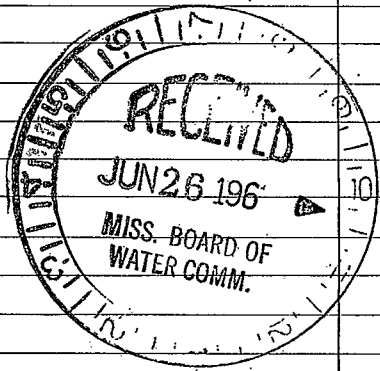

Well No.

(Use Back Side)

