

WATER WELL DRILLERS LOG

James A. Lipe

Date: 4-27, 1965, Driller: Frank Taylor, County: Panola

(Name)

(1) Owner of Land: M. M. Randal/Ph (Name)		Description & Color of Materials Sand, Clay, Red Clay, Shell, etc.	Thickness Feet	Depth Feet
Batesville (Address)		Top soil	8	23
(2) Location: 1/4, 1/4, Sec. 16 T10 R2 E S		Back shot clay	23	43
8 miles West of Pope (distance) (direction) (Nearest Town)		Blue clay	23	63
(3) Topography: flat (Hilly) (Flat) (Level)		sand and gravel	63	83
(4) Purpose of Well: domestic (Domestic Irrigation Municipal, Industrial, Other)		gravel to 90'	83	103
		Pulled back to 91'		

Information upon completion of well:

(1) Diameter 4 inches.

(2) Total Depth 91 feet.

(3) Water Level \_\_\_\_\_ feet below top of ground.

(4) Cased to \_\_\_\_\_, Size \_\_\_\_\_

(5) Screen: Size 4", Length 6


(6) Were any formations sealed against pollution?  
\_\_\_\_\_ yes, \_\_\_\_\_ no.

If YES depth of formation \_\_\_\_\_

Why \_\_\_\_\_

Drillers Remarks: 0124 from

91 TO 103'

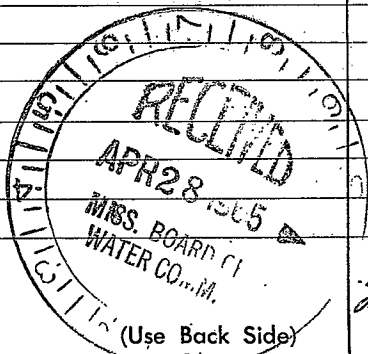

Well No. 27

