

Panola
 6613
 5-20-70

MISSISSIPPI
 BOARD OF WATER COMMISSIONERS
 416 North State Street
 Jackson, Mississippi 39201

CODED

WATER WELL DRILLERS LOG

5-20-70 date well completed James R. Lipe firm name Panola county well located

LANDOWNER: Mrs Jennie Hentz
 Courtland Miss.
 (mailing address)

description of formations encountered	from	to
Clay	0	20
sand	20	40
ll	40	68

WELL LOCATION:
 sec 29 27 N R 3 E
 3 miles West of Pope
 (distance) (direction) (nearest town)

WELL PURPOSE: NONE
 (home, irrigation, municipal, industrial)

- WELL COMPLETION DATA:
- (1) diameter (inches) 4
 - (2) total depth (feet) 68
 - (3) static water level (feet) 20 below top of ground.
 - (4) casing PVC, 58 (material) (depth)
 4 (size) if telescope see back.
 - (5) screen 10, 58 (length) (depth to top)
 4, PVC (size) (material)
 - (6) pump 1/2, 20 (HP) (yield gpm)
 Elec. (type power)
 - (7) electric log no (yes or no)
 no (organization running log)
 - (8) how well bottom plugged PVC plug

CODED


JUL 10 1970

MISS. BD. OF WATER COMMISSIONERS

DRILLERS REMARKS:

If well telescopes please sketch and show depths.

GROUND LEVEL

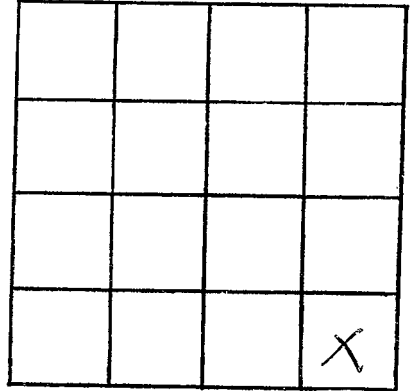

SECTION 29

Please indicate well location X.

ADDITIONAL INFORMATION

If more than one screen, show locations of each on sketch.