

PANOLA
U 15
5-21-71

MISSISSIPPI
BOARD OF WATER COMMISSIONERS
416 North State Street
Jackson, Mississippi 39201

WATER WELL DRILLERS LOG

CODED

May 21 1971 date/well completed
Lipe Well Co. firm name
Panola county well located

LANDOWNER:
Kelly Benson
Pope, Miss.
(mailing address)

description of formations encountered	from	to
	top soil	0
sand & gravel	10	40
clay	40	70
sand	70	140

WELL LOCATION:
sec. 19 T. 27 N. R. 3 E
5 miles W of Pope
(distance) (direction) (nearest town)

WELL PURPOSE: Home
(home, irrigation, municipal, industrial)

- WELL COMPLETION DATA:
- (1) diameter (inches) 4"
 - (2) total depth (feet) 138
 - (3) static water level (feet) 90 ^{below} ~~above~~ top of ground.
 - (4) casing PVC 130'
(material) (depth)
4" if telescope see back.
(size)
 - (5) screen 8' 130'
(length) (depth to top)
4" PVC & silica
(size) (material)
 - (6) pump 3/4 10
(HP) (yield gpm)
elec.
(type power)
 - (7) electric log no
(yes or no)
 - (organization running log)
 - (8) how well bottom plugged PVC cap

CODED


OCT 12 1971

DRILLERS REMARKS:

MISS. BD. OF
WATER COMMISSIONERS

If well telescopes please sketch and show depths.

GROUND LEVEL

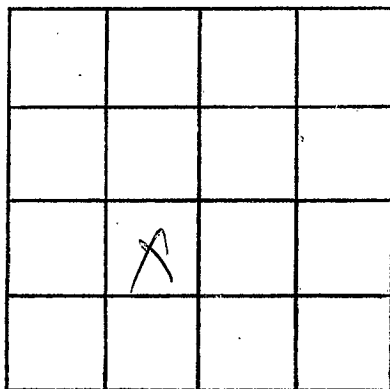

SECTION 19

Please indicate well location X.

ADDITIONAL INFORMATION

Lined area for additional information.

If more than one screen, show locations of each on sketch.