

Panola  
U 22  
1-67

MISSISSIPPI  
BOARD OF WATER COMMISSIONERS  
416 North State Street  
Jackson, Mississippi 39201  
WATER WELL DRILLERS LOG

**CODED**

1-6 1967 Ralstonson Panola  
date well completed firm name county well located

LANDOWNER: Audley Tucker  
Route 2  
Coastland, Miss  
(mailing address)

description of formations encountered	from	to
<u>Red Clay</u>	<u>0</u>	<u>40</u>
<u>Sand + Clay</u>	<u>40</u>	<u>80</u>
<u>Shale</u>	<u>80</u>	<u>200</u>
<u>Sand</u>	<u>200</u>	<u>240</u>


WELL LOCATION:  
sec. 8 T 27 N R 2 E  
S W  
8 miles SW of Batesville  
(distance) (direction) (nearest town)

WELL PURPOSE: Home  
(home, irrigation, municipal, industrial)

WELL COMPLETION DATA:

- (1) diameter (inches) 2 in
- (2) total depth (feet) 240
- (3) static water level (feet) 140 below above top of ground.
- (4) casing Plastic, 235'  
(material) (depth)  
2 in if telescope see back.  
(size)
- (5) screen 5 ft, 235'  
(length) (depth to top)  
4 in, gravel packed  
(size) (material)
- (6) pump 2 HP, 6  
(HP) (yield gpm)  
TVA 110  
(type power)
- (7) electric log no  
(yes or no)  
(organization running log)
- (8) how well bottom plugged Plastic Cap

**CODED**

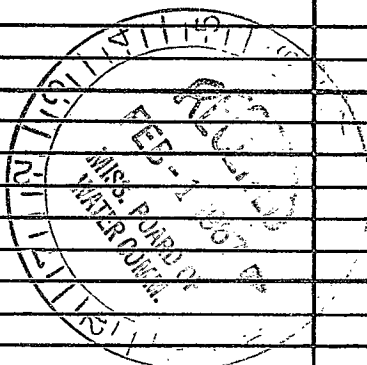

DRILLERS REMARKS: Plastic Water Well

If well telescopes please sketch and show depths.

GROUND LEVEL

X			

SECTION 8

Please indicate well location X.

ADDITIONAL INFORMATION

If more than one screen, show locations of each on sketch.