

Plugged and Abandoned
WATER WELL DRILLERS LOG
CODED

U33
10-25-61

Date: Oct. 25, 19 61, Driller: Layne-Central Co. County: [unclear]
(Name)

(1) Owner of Land: Town of Crowder
(Name)
Crowder, Mississippi
(Address)

(2) Location: NW 1/4, NW 1/4, Sec. 31 T27N R2E
_____ miles _____ of _____
(distance) (direction) (Nearest Town)

(3) Topography: _____
(Hilly) (Flat) (Level)

(4) Purpose of Well: Municipal
(Domestic Irrigation
Municipal, Industrial, Other)

Description & Color of Materials Sand, Clay, Red Clay, Shell, etc.	Thick- ness Feet	Depth Feet
clay	27	27
sand	45	72
sand & gravel	55	127
clay	13	140
sandy clay	53	193
shale	6	199
rock	1	200
sandy shale-boulders	18	218
rock	2	220
hard sandy shale	22	242
shale stks sand	12	354
sand	11	365
shale stks sand	25	390
sand	9	399
sandy shale	16	415
shale	63	478
sand	12	490
sandy shale	30	520
sand	10	530
shale stks sand	55	585
shale	8	593
sand stks shale	62	655
draggy sand	70	725
shale stks sand	35	760
rock	1	761
shale stks sand	15	776
rock	1	777
shale stks sand	6	783
rock	1	784
shale stks lignite	100	884
h.p. sand	21	905
h.p. sand	22	927
shale	1	928

Information upon completion of well:

(1) Diameter 8" inches

(2) Total Depth 931' 6" feet.

(3) Water Level 19' 6" feet below top of ground.

(4) Cased to 756' 8", Size 6"


(5) Screen: Size 4", Length 41' 8"

(6) Were any formations sealed against pollution?
X yes, _____ no.

If YES depth of formation 756' 8"

Why Required

Drillers Remarks:

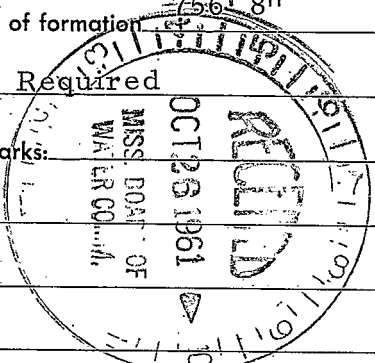

(Use Back Side)

