

Panola  
U 38  
8-25-73

MISSISSIPPI  
 BOARD OF WATER COMMISSIONERS  
 416 North State Street  
 Jackson, Mississippi 39201

**CODED**

WATER WELL DRILLERS LOG

8-25 1973 JAMES R. LIPE Panola  
 date well completed firm name county well located

LANDOWNER:  
Earl Johnson  
POPE MISS.  
 (mailing address)

description of formations encountered	from	to
<u>Top Soil</u>	<u>0</u>	<u>20</u>
<u>Clay red gravel</u>	<u>20</u>	<u>40</u>
<u>gravel</u>	<u>40</u>	<u>60</u>
<u>cl</u>	<u>60</u>	<u>80</u>
<u>Sand and gravel</u>	<u>80</u>	<u>100</u>
<u>White sand</u>	<u>100</u>	<u>120</u>
<u>cl cl</u>	<u>120</u>	<u>154</u>

WELL LOCATION:  
 sec. 19 T 27 N R 3 E  
3 miles S.W. of POPE  
 (distance) (direction) (nearest town)

WELL PURPOSE:  
 (home) irrigation, municipal, industrial

- WELL COMPLETION DATA:
- (1) diameter (inches) 4
  - (2) total depth (feet) 154
  - (3) static water level (feet) 100 below top of ground.
  - (4) casing PVC, 144,  
 (material) (depth)  
4 if telescope see back.  
 (size)
  - (5) screen 10, 144  
 (length) (depth to top)  
4, PVC  
 (size) (material)
  - (6) pump 3/4, 10  
 (HP) (yield gpm)  
elec.  
 (type power)
  - (7) electric log no  
 (yes or no)  
no  
 (organization running log)
  - (8) how well bottom plugged PVC  
PLUG

**CODED**


SFP 6 1973

DRILLERS REMARKS:

MISS. Bd. of  
 WATER COMMISSIONERS

If well telescopes please sketch and show depths.

GROUND LEVEL

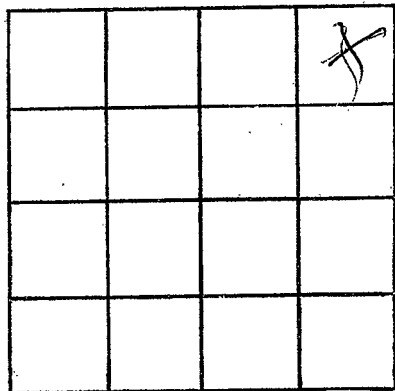

SECTION 19

Please indicate well location X.

ADDITIONAL INFORMATION

If more than one screen,  
show locations of each on sketch.