

PANOLA
 U39
 4-15-74

MISSISSIPPI
 BOARD OF WATER COMMISSIONERS
 416 North State Street
 Jackson, Mississippi 39201


CODED

WATER WELL DRILLERS LOG

4-15 date well completed
 1974 Live Well Co. firm name
 Panola county well located

LANDOWNER:	description of formations encountered	from	to
Bill McCahren Enid Miss. (mailing address)			
	Gravel	20	40
	Sand	40	60
		60	90
WELL LOCATION: sec. 33 T 27 N R 3 E S W 5 miles S. W. of Pipe (distance) (direction) (nearest town)			
WELL PURPOSE: (home irrigation, municipal, industrial)			
WELL COMPLETION DATA: (1) diameter (inches) 4 (2) total depth (feet) 90 (3) static water level (feet) 40 below top of ground. (4) casing PVC 80 (material) (depth) 4 (size) If telescope see back. (5) screen 10 80 (length) (depth to top) 4 PVC (size) (material) (6) pump 3/4 10 (HP) (yield gpm) elec. (type power) (7) electric log NO (yes or no) NO (organization running log) (8) how well bottom plugged PVC plug			
DRILLERS REMARKS:			


CODED

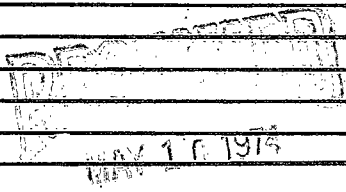

MISS. BD. OF WATER COMMISSIONERS

If well telescopes please sketch and show depths.

GROUND LEVEL

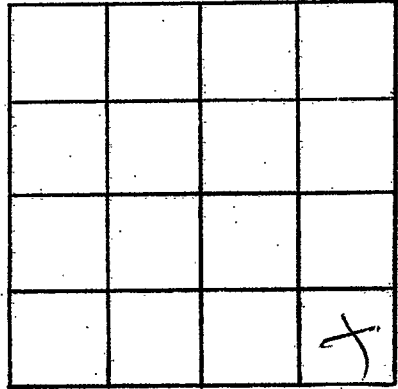

SECTION 33

Please indicate well location X.

ADDITIONAL INFORMATION

If more than one screen,
show locations of each on sketch.