

U 41
 Panola
 5/15/75

MISSISSIPPI
 BOARD OF WATER COMMISSIONERS
 416 North State Street
 Jackson, Mississippi 39201

WATER WELL DRILLERS LOG

CODED

Panola

5-15
 date well completed

1975 J B Cain
 firm name

county well located

LANDOWNER: M Whitweathers
 Crowder Ms

description of formations encountered	from	to
Sand	0	60
Lightlime Strata	60	70
SAND	70	180

(mailing address)

WELL LOCATION:

sec. 29 T 27 N R 2 E
 S W
 2 miles N-E of Crowder
 (distance) (direction) (nearest town)

WELL PURPOSE: Home
 (home, irrigation, municipal, industrial)

WELL COMPLETION DATA:

- (1) diameter (inches) 4
- (2) total depth (feet) 180
- (3) static water level (feet) 60 below above top of ground.
- (4) casing Plastic, 180 (material) (depth)
- (5) screen 10' 170 (length) (depth to top)
 4" Plastic (size) (material)
- (6) pump 1/2 10 (HP) (yield gpm)
 Elect (type power)
- (7) electric log (yes or no)

WL can't be 60'
 if location OK
 CODED

(size) if telescope see back.

(organization running log)

(8) how well bottom plugged Plug


RECEIVED
 JUN 9 1975

DRILLERS REMARKS:

MISS. BD. OF WATER COMM.

If well telescopes please sketch and show depths.

GROUND LEVEL

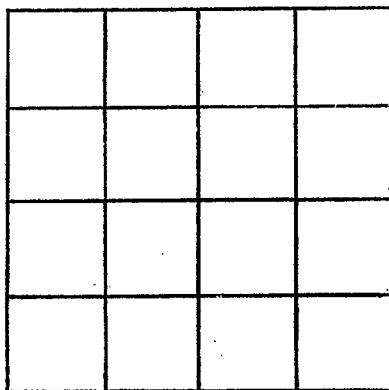

SECTION _____

Please indicate well location X.

ADDITIONAL INFORMATION

If more than one screen,
show locations of each on sketch.