

Panola
U-44
3-3-80
3-3
 date well completed

MISSISSIPPI
 BOARD OF WATER COMMISSIONERS
 416 North State Street
 Jackson, Mississippi 39201

CODED

WATER WELL DRILLERS LOG

1980 Life Well Co. Panola
 firm name county well located

LANDOWNER:
Walter Guy Burkhalter
Enid MS.
 (mailing address)

description of formations encountered	from	to
<u>Top soil</u>	<u>0</u>	<u>20</u>
<u>Gravel</u>	<u>20</u>	<u>70</u>
<u>Sand and Gravel</u>	<u>70</u>	<u>79</u>

WELL LOCATION:
 sec. 27 T 27 N R 2 E
3 miles East of Crowder
 (distance) (direction) (nearest town)

WELL PURPOSE:
 Irrigation municipal, industrial

CODED

- WELL COMPLETION DATA:
- (1) diameter (inches) 2
 - (2) total depth (feet) 79
 - (3) static water level (feet) 10 below top of ground.
 - (4) casing PVC 69
 (material) (depth)
2 If telescope see back.
 (size)
 - (5) screen 10 69
 (length) (depth to top)
2 PVC
 (size) (material)
 - (6) pump 50
 (HP) (yield gpm)
Gasoline
 (type power)
 - (7) electric log no
 (yes or no)
no
 (organization running log)
 - (8) how well bottom plugged PVC
PVC

DEPT. OF NATURAL RESOURCES
 BUREAU OF LAND & WATER RESOURCES


APR 14 1980

DRILLERS REMARKS:

RECEIVED

If well telescopes please sketch and show depths.

GROUND LEVEL

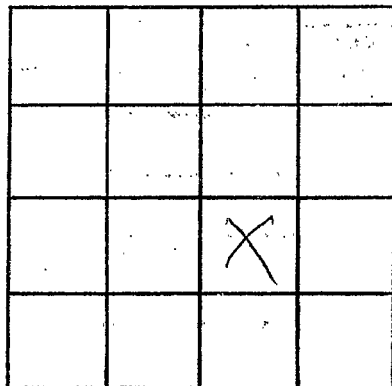

SECTION 27

Please indicate well location X.

ADDITIONAL INFORMATION

If more than one screen,
show locations of each on sketch.