

PANOLA
U-45
3-3-80
3-3

MISSISSIPPI
 BOARD OF WATER COMMISSIONERS
 416 North State Street
 Jackson, Mississippi 39201

CODED

WATER WELL DRILLERS LOG

date well completed 1980 firm name Lipe Well Co. Panola county well located

LANDOWNER:	description of formations encountered	from	to
<u>Walter Guy Burkhalter</u> <u>Enid MS.</u> (mailing address)			
	<u>Gravel</u>	<u>20</u>	<u>30</u>
	<u>Clay</u>	<u>30</u>	<u>40</u>
	<u>Coarse sand</u>	<u>40</u>	<u>91</u>
WELL LOCATION:			
sec. <u>34 T 27 N S</u> R <u>2 E W</u>			
<u>4</u> miles <u>East</u> of <u>Crowder</u> (distance) (direction) (nearest town)			
WELL PURPOSE: (home, irrigation, municipal, industrial)			
CODED			
WELL COMPLETION DATA:			
(1) diameter (inches) <u>2</u>			
(2) total depth (feet) <u>91</u>			
(3) static water level (feet) <u>15</u> below above top of ground.			
(4) casing <u>PVC</u> <u>81</u> (material) (depth)			
<u>2</u> If telescope see back. (size)			
(5) screen <u>10</u> <u>81</u> (length) (depth to top)			
<u>2</u> <u>PVC</u> (size) (material)			
(6) pump <u>50</u> (HP) (yield gpm)			
<u>Gasoline</u> (type power)			
(7) electric log <u>NO</u> (yes or no)			
<u>NO</u> (organization running log)			
(8) how well bottom plugged <u>Pvc</u> <u>cap</u>			
DRILLERS REMARKS:			


DEPT. OF NATURAL RESOURCES
 BUREAU OF LAND & WATER RESOURCES

APR 14 1980

RECEIVED

If well telescopes please sketch and show depths.

GROUND LEVEL

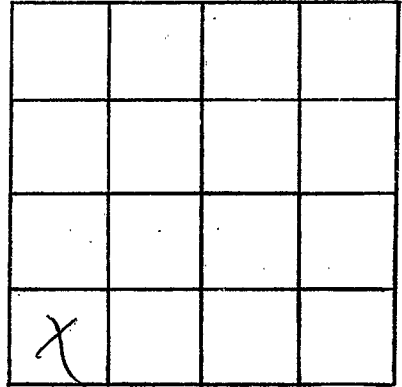

SECTION 34

Please indicate well location X.

ADDITIONAL INFORMATION

If more than one screen,
show locations of each on sketch.