

U-46  
 PANOLA  
 7-17-80

MISSISSIPPI  
 BOARD OF WATER COMMISSIONERS  
 416 North State Street  
 Jackson, Mississippi 39201

CODED

WATER WELL DRILLERS LOG

7-17 1980 Lipc Well Co. Panola  
 date well completed firm name county well located

LANDOWNER:	description of formations encountered	from	to
Ruby Jones Crowder MS. (mailing address)	Topsoil	0	20
WELL LOCATION: sec. 30 T. 27N R. 2 E S W 1 miles north of Crowder (distance) (direction) (nearest town)	Coarse sand	20	80
WELL PURPOSE: (home) irrigation, municipal, industrial	CODED		
WELL COMPLETION DATA:			
(1) diameter (inches) 4			
(2) total depth (feet) 80			
(3) static water level (feet) 20 below top of ground.			
(4) casing PVC 20 (material) (depth)			
4 If telescope see back. (size)			
(5) screen 10 20 (length) (depth to top)			
4 PVC (size) (material)			
(6) pump 3/4 10 (HP) (yield gpm)			
elec. (type power)			
(7) electric log no (yes or no)			
(organization running log)			
(8) how well bottom plugged PVC plug			
DRILLERS REMARKS:			


DEPT. OF NATURAL RESOURCES  
 BUREAU OF LAND & WATER RESOURCES

SEP 2 - 1980

RECEIVED

If well telescopes please sketch and show depths.

GROUND LEVEL

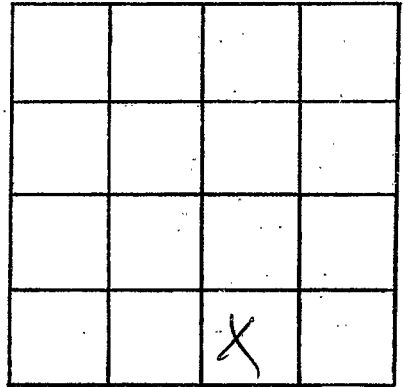

SECTION 30

Please indicate well location X.

ADDITIONAL INFORMATION

A series of horizontal lines for writing additional information.

If more than one screen, show locations of each on sketch.