

MISSISSIPPI DEPARTMENT OF NATURAL RESOURCES

Bureau of Land and Water Resources

Southport Mall

P.O. Box 10631

Jackson, Mississippi 39209

WATER WELL DRILLERS LOG CODED

Panola
Page U50
5-21-81

5-21-81 19 DYER WELL DRILLERS PANOLA
 date well completed firm name county well located

LANDOWNER:
WILLIAM POND

description of formations encountered	from	to
<u>Gravelly sand</u>	<u>13</u>	<u>23</u>
<u>sand</u>	<u>23</u>	<u>33</u>
<u>sand</u>	<u>33</u>	<u>43</u>
<u>sand</u>	<u>43</u>	<u>53</u>
<u>sand</u>	<u>53</u>	<u>63</u>
<u>hard gravel</u>	<u>63</u>	<u>73</u>
<u>Gravel</u>	<u>73</u>	<u>83</u>
<u>sand</u>	<u>83</u>	<u>93</u>
<u>sand</u>	<u>93</u>	<u>103</u>
<u>sand</u>	<u>103</u>	<u>113</u>
<u>hard gravel</u>	<u>113</u>	<u>123</u>
<u>hard gravel</u>	<u>123</u>	<u>133</u>
<u>hard gravel</u>	<u>133</u>	<u>143</u>
<u>Gravel</u>	<u>143</u>	<u>153</u>


(mailing address)

WELL LOCATION:
 sec. 8 T 27 S R 10
2 miles N-F of Crowder
 (distance) (direction) (nearest town)


WELL PURPOSE:
 (home, irrigation, municipal, industrial)

WELL COMPLETION DATA:

- (1) diameter (inches) 16
- (2) total depth (feet) 153
- (3) static water level (feet) 27 below top of ground
- (4) casing 16 153
 (material) (depth)
 (size) if telescope see back.
- (5) screen 10' 153
 (length) (depth to top)
1 1/2" Steel
 (size) (material)
- (6) pump 60 1500
 (HP) (yield gpm)
DEBBEL
 (type pump)
- (7) electric log NS
 (yes or no)
- (organization running log)
- (8) how well bottom plugged Steel
PLATE

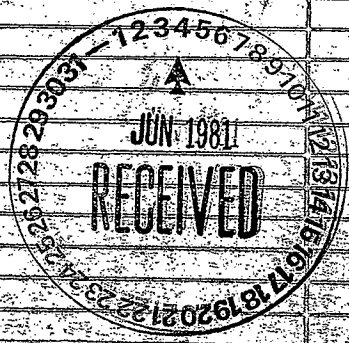

DRILLERS REMARKS:

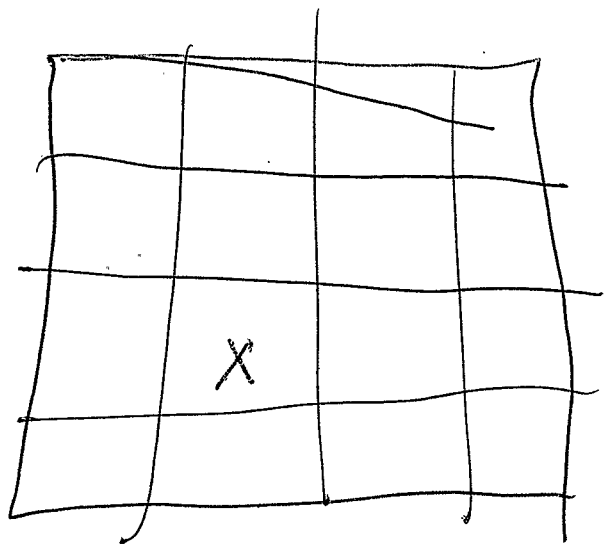

sec 8