

MISSISSIPPI DEPARTMENT OF NATURAL RESOURCES

Bureau of Land and Water Resources

Southport Mall

P.O. Box 10631

CODED

Jackson, Mississippi 39209

WATER WELL DRILLERS LOG

U59  
 PANOLA  
 4-84

April 84 date well completed  
 Leeper Drilling firm name  
 PANOLA county well located

LANDOWNER: Hosey White  
Crowder MS  
 (mailing address)

description of formations encountered	from	to
TOP CLAY	0	20
COARSE SAND	20	50
Gravel	50	95

WELL LOCATION:  
 sec. 18 T. 29 N. R. 20 E.  
3 miles (distance) N (direction) of Crowder (nearest town)

WELL PURPOSE: Domestic  
 (home, irrigation, municipal, industrial)

WELL COMPLETION DATA:

(1) diameter (inches) 10"

(2) total depth (feet) 95

(3) static water level (feet) 2 below above top of ground.

(4) casing PVC 55'  
 (material) (depth)

10" (size) If telescope see back.

(5) screen 40' 55'  
 (length) (depth to top)

10" (size) PVC (material)

(6) pump 20 800  
 (HP) (yield gpm)

Diesel (type power)

(7) electric log NO  
 (yes or no)

(organization running log)

(8) how well bottom plugged Well Cap

DRILLERS REMARKS:


DEPT. OF NATURAL RESOURCES  
 BUREAU OF LAND & WATER RESOURCES

MAY 31 1984  
 RECEIVED

④

If well telescopes please  
sketch and show depths.

GROUND LEVEL

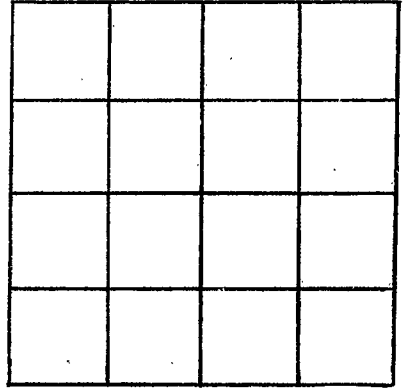

SECTION \_\_\_\_\_

Please indicate well location X.

ADDITIONAL INFORMATION

If more than one screen,  
show locations of each on sketch.