

# State Well Report

## Part 1

Mississippi Department of Environmental Quality  
Office of Land and Water Resources  
P.O. Box 10631  
Jackson, MS 39289-0631  
(601)961-5210  
(601)354-6938 (fax)

For Office Use Only:

Aquifer: \_\_\_\_\_  
Well #: U-82  
L. S. Elevation: \_\_\_\_\_  
E-log #: \_\_\_\_\_

County: Panola  
Permit #: \_\_\_\_\_  
Driller: Pete Sappington  
Date drilling completed: 5/2/06

State Law requires that this report be prepared by the driller in detail and filed with the Department within 30 days of completion of drilling of the well.

Well Owner Information	Well Location
Owner Name: <u>Gary Cannon</u>	Latitude: <u>31° 14' 13"</u> Longitude: <u>90° 4' 47"</u>
Mailing Address: <u>195 Atkinson Rd</u> <u>Batesville, MS</u>	Method of Lat/Long (circle one): Conventional Survey, USGS quad, Hand-held GPS, Survey-grade GPS
City: _____ State: _____ Zip Code: <u>38606</u>	<u>NW 1/4 NE 1/4 Sec 7 Twn <sup>10S</sup> 28 N Rng <sup>8W</sup> 2 E</u>
Telephone No. <u>(662) 326-4432</u>	Distance: <u>8</u> Miles Direction: <u>SW</u> of Nearest Town: <u>Courtland</u>

### Well Data

Purpose of Well (circle one) Home Industrial Public Supply Irrigation Fish Culture Other: \_\_\_\_\_  
Date well drilling started: 5/2/06 Date well drilling completed: 5/2/06  
If flowing, method of flow regulation: Valve \_\_\_\_\_ Other (describe) \_\_\_\_\_  
Static Water Level: 11 feet above or below (circle one) land surface Date measured: 5/2/06  
Method of Measurement (circle one) steel tape electric tape air line other: \_\_\_\_\_  
Hole depth: 100' Well depth: 94' Well grouted to a depth of 10 feet  
Type of grout (circle one): Cement Bentonite Mix  
Casing length: 54 feet Casing diameter: 12 inches Type of casing: PVC  
Screen length: 40 feet Screen diameter: 12 inches Type of screen: PVC  
Screen slot size: 50 inches Setting depth: From 54 feet to 94 feet  
Type of completion (circle all applicable): Gravel packed Underreamed Telescoped Open hole Natural Development  
Other (describe): \_\_\_\_\_  
Top of lap pipe or reduction in casing: \_\_\_\_\_ feet. If telescoped or more than one screen, describe on back of page  
Logs run (circle all applicable): No log run Electric Gamma Ray Density Sonic Neutron Other: \_\_\_\_\_  
Name of organization running log(s): \_\_\_\_\_

I certify that the well was drilled, constructed, and completed in accordance with all applicable requirements of the Mississippi Department of Environmental Quality and/or the Mississippi Department of Health regulations and state laws.

Pete Sappington 0430  
Print Name of Water Well Contractor and License No.

Pete Sappington  
Signature of Water Well Contractor

No part 2

RECEIVED  
MAY 10 2006  
BY CLAW

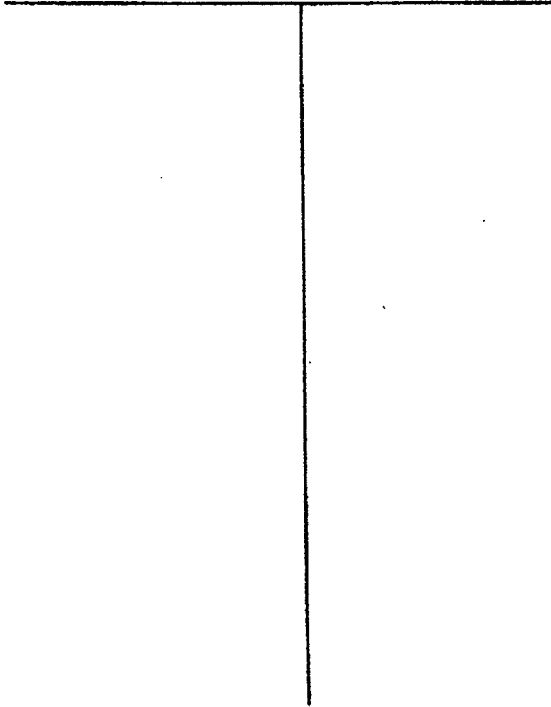
U-82

If well telescopes please sketch below and show depths.

Ground Level

Description of Formations Encountered

From To

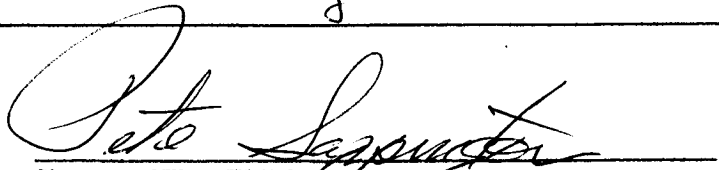

---

Description of Formations Encountered	From	To
Clay	0	28
fine S. Sand	28	40
Coarse Sand + Gravel	40	94
fine Sand	94	100

If more than one screen, show location of each on sketch

Sketch the property layout and include the following: 1) the well location; 2) any permanent structures on the property that may aid in locating the well; 3) any roads, power lines, or other items that may aid in locating the property and the well; 4) indicate direction.

Landowner Name: Dary Cannon

  
 Signature of Water Well Contractor

RECEIVED  
 MAY 23 1988  
 BY: CLWH