

County: PANOLA
 Permit #: GW-16977
 Driller: BATIFF Water Well
 Date drilling completed: Feb. 18, 2013

State Well Report
Part 1 – Driller's Log

Mississippi Department of Environmental Quality
 Office of Land and Water Resources
 P.O. Box 10631
 Jackson, MS 39289-0631
 (601)961-5210
 (601)354-6938 (fax)

For Office Use Only:
 Aquifer: SPRT
 Well #: U 96
 L. S. Elevation: 344
 E-log #: _____

State Law requires that this report be prepared by the license holder responsible for the work and filed with the Department at the above address within 30 days of completion of drilling of the well or borehole.

Information on Well Owner (Landowner if borehole is not for a water well)	Well or Borehole Location
Owner Name: <u>INDEPENDENCE WATER</u>	Latitude: <u>N34° 14' 50.7"</u> Longitude: <u>W89° 59' 46.7"</u>
Mailing Address: <u>1247 BENSON ROAD</u>	Method of Lat/Long (circle one): Conventional Survey,
<u>Courtland, Ms. 38620</u>	USGS quad. <u>Hand-held GPS</u> , Survey-grade GPS
City State Zip Code	<u>SE 1/4 NW 1/4 Sec 1 Twn 10S Rng 8W</u>
Telephone No. () _____	Distance Direction Nearest Town <u>5</u> Miles <u>South</u> of <u>Batesville, Ms.</u>

Well / Borehole Data

Date drilling started: 8/12 Date drilling completed: 1/2013 Hole depth: 275' Hole diameter: 7 1/2"

Location of the source of any surface water used for drilling: Assoc. Well

Method of dosing and volume of Chlorine used in drilling and development: HTH 50# 6590 6500 gallons

Logs run (circle all applicable): No log run Electric Gamma Ray Density Sonic Neutron Other: _____

Name of organization running log(s): STATE

Purpose of borehole (check one): Water Well Geotechnical/Geological Investigation _____ Ground Source Heat Pump _____

Seismic Survey _____ Other (describe) _____

If drilling is not related to water well construction, skip the remainder of this block

Purpose of Well (check one): Home _____ Industrial _____ Public Supply Irrigation _____ Fish Culture _____ Other: _____

If a flowing well, method of flow regulation: Valve _____ Other (describe) _____

Static Water Level: 148 feet above or below (circle one) land surface Date measured: 1-27-13

Method of Measurement (circle one) steel tape electric tape air line other: _____

Well depth: 240 Well grouted to a depth of 208 feet Type of grout (circle one) Neat Cement Bentonite Mix

Casing length: 208 feet Casing diameter: 10 inches Type of casing: Steel

Screen length: 20 feet Screen diameter: 6 inches Type of screen: STAINLESS

Screen slot size: .020 inches Setting depth: From 220 feet to 240 feet

Type of completion (circle all applicable): Gravel packed Underreamed Telescoped Open hole Natural Development

Other (describe): _____

Top of lap pipe or reduction in casing: 159 feet. *If telescoped or more than one screen, describe on next page*

Form: OLWR-SWR-1A

RECEIVED
 MAR 14 2013
 BY: OLWR

STATE WELL REPORT

Part 2

Pump Installer's Completion Report
 Mississippi Department of Environmental Quality
 Office of Land and Water Resources
 P.O. Box 10631
 Jackson, MS 39289-0631
 (601)961-5210
 (601)354-6938 (fax)

County: PANOLA
 Permit #: 6W-16977
 Driller: RATLIFF Water Well
 Date completed: 2-18-13
Copy information from block on Part 1

For Office Use Only:

Aquifer: SPRT
 Well #: U96
 Elevation: 344

This part of the report must be completed by a licensed water well contractor or a licensed pump installer. A copy of Part 1 of the report must be attached and both parts filed with the Department at the above address within 30 days of well completion.

Well Owner Information	Well Location
Owner Name: <u>Independence Water</u>	Latitude: <u>N34°14'50.7"</u> Longitude: <u>W089°59'46.7"</u>
Mailing Address: <u>1247 Benson Road</u>	Method of Lat/Long (check one): Conventional Survey <input type="checkbox"/> , USGS quad <input type="checkbox"/> , Hand-held GPS <input checked="" type="checkbox"/> , Survey-grade GPS <input type="checkbox"/>
<u>Courtland</u> <u>Ms.</u> <u>38620</u>	<input type="checkbox"/> $\frac{1}{4}$ <input type="checkbox"/> $\frac{1}{4}$ Sec <u>1</u> T <u>28N</u> R <u>3E</u>
Telephone No. () _____	Distance Direction Nearest Town <u>5</u> Miles <u>South</u> of <u>Batesville, Ms.</u>

Pump Type Circle one	Power Type Circle one
Air Lift Jet <u>Submersible</u>	Diesel Engine Gasoline Engine Natural Gas
Bucket Piston Turbine	<u>Electric Motor</u> Hand Tractor PTO
Centrifugal Rotary Flowing Well	Windmill Other (specify): _____
Other (specify): _____	Horse Power Rating of Motor: <u>20</u>
Date Pump Installed: <u>1-26-2013</u>	Setting Depth: <u>231</u> feet
Rated Pump Capacity: <u>180</u> Gallons Per Minute	Number of Stages: <u>8</u>

Pump Test Data	Method of Measuring Water Level Circle one
Date Well Tested: <u>2-7-2013</u>	Air Line <u>Electric Measuring Line</u> Steel Tape
Static Water Level (A): <u>148</u> Feet Below Land Surface	Other (specify): _____
Pumping Water Level (B): <u>200</u> Feet Below Land Surface	For flowing well, measured shut in head: _____ feet
Drawdown [(B) - (A)]: <u>52</u> Feet Below Land Surface	Well yielded <u>180</u> GPM with a drawdown of
Test Pumping Rate: <u>180</u> Gallons Per Minute	<u>52</u> feet after <u>4</u> hours of pumping
Duration of Pump Test (minimum 4 hours): <u>4</u> hours	

I HEREBY CERTIFY that the above statements are true to the best of my knowledge.


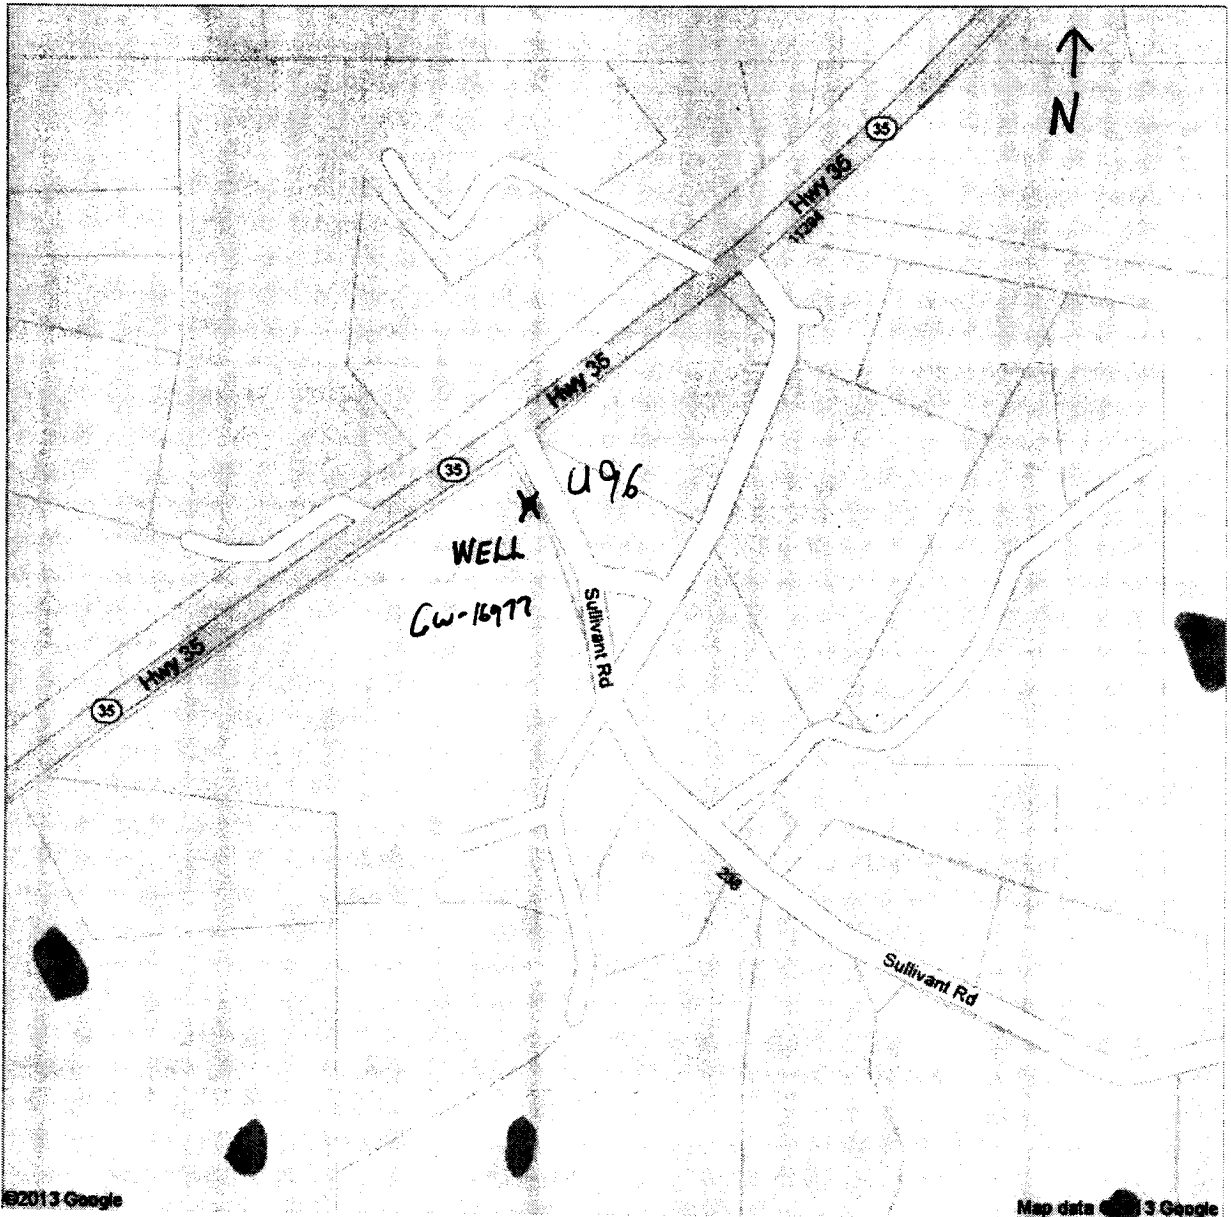
Robert E. Ratliff 0-002 Robert E. Ratliff
 Print Name of Pump Installer and License No. (if applicable) Signature of Pump Installer

Form: OLWR-SWR-1B
RECEIVED
MAR 14 2013
BY: OLWR




Address Sullivant Rd
Batesville, MS 38606

Get Google Maps on your phone
Text the word "GMAPS" to 466453

RECEIVED
MAR 14 2013
BY: OLWR

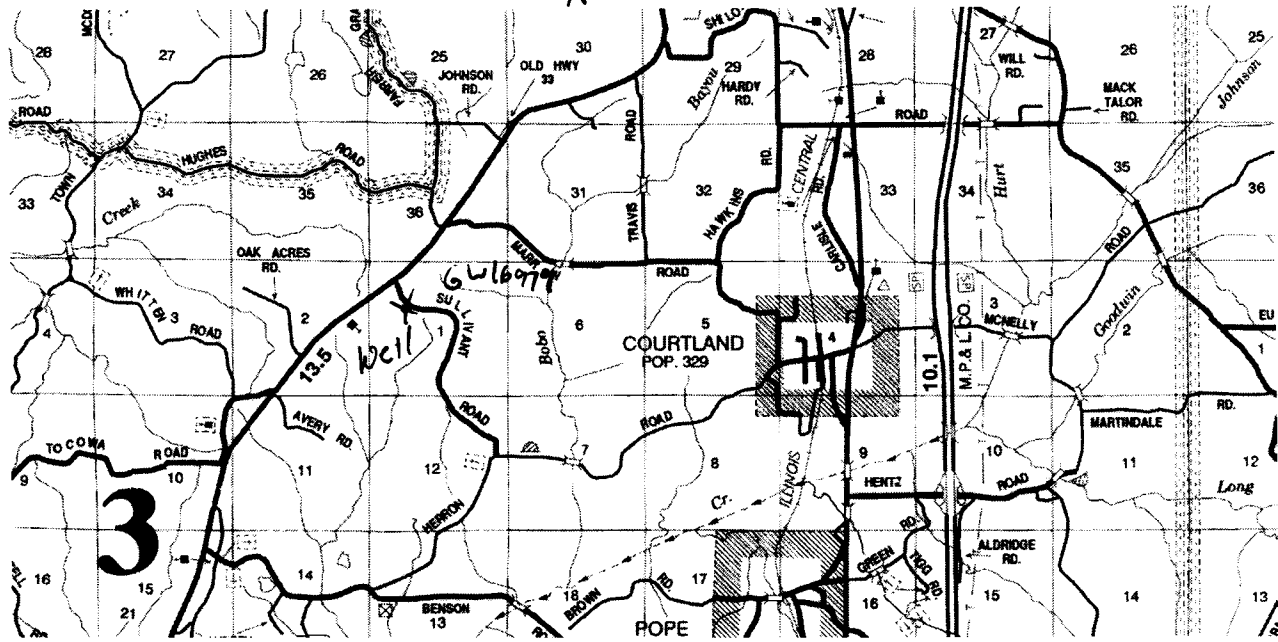

U 96

RECEIVED
MAR 14 2013
BY: OLWR