| 1 | | |
|---|---|---|
| 1 | G | 7 |
| | 7 | 1 |

County: PANOLA Permit #: GW-51045 Driller: CHAD MATTOX Date drilling completed: 11/12/20

Well Owner Information (Landowner if borehole is not for a water well)

STATE WELL REPORT Part 1

Driller's Log
Mississippi Department of Environmental Quality
Office of Land and Water Resources P.O. Box 2309 Jackson, MS 39225-2309 (601)961-5210

(601)360-0535 (fax)

| 1 | 1 | |
|--------------|----------|---|
| For Office U | se Only: | |
| Well #: | 08 | |
| Aquifer: | | |
| E-Log #: | | |
| | | _ |

State Law requires that this report be prepared by the license holder responsible for the work and filed with the Department at the above address within 30 days of completion of drilling of the well or borehole. Well or Borehole Location

| (Landowner if borehole is | not for a water well) | Latitude: 34 10 45N Longitude: 9 | 90 00 35W | | |
|---|---|---|-----------------------|--|--|
| Owner Name: HARTZELL | BROTHERS INC | Method of Lat/Long (check one): Conver | 90.009722 | | |
| Mailing Address: | | | | | |
| 7300 HWY 35 SOUTH | 1 | USGS quad O , Hand-held GPS O , S | | | |
| BATESVILLE | MS 38606 | NE SW | 2/N R 03E | | |
| City | State Zip Code | Miles of | | | |
| Telephone No. () | | (Distance) (Direction) | (Nearest Town) | | |
| | Well / | Borehole Data | | | |
| Date drilling started: 11/12/2 | 2(Date drilling completed | d: 11/12/20 Hole depth: 67' Hole | diameter: 24" | | |
| Location of the source of any s | surface water used for drill | ling: | | | |
| Method of dosing and volume of | Method of dosing and volume of Chlorine used in drilling and development: | | | | |
| Logs run (check all applicable): | ☑No log run ☐Electric ☐G | amma Ray□Density□Sonic□Neutron □Ot | her: | | |
| Name of organization running log(s): | | | | | |
| | | | | | |
| If drilling is not related to water well construction, skip the remainder of this block | | | | | |
| | | strial Public Supply Irrigation Fish C | | | |
| Other (describe): | | | | | |
| | | Other (describe) | | | |
| | | | | | |
| Static Water Level: 22 | feet Oabove/Obelow (select one) | and surface Date measured: | | | |
| Method of measurement (sele | | ctric tape Air line Other (describe): | | | |
| Well depth: 67' Well gro | uted to a depth of: 10 | _ feet Type of grout (select one): O Neat C | ement OBentonite OMix | | |
| Casing length: 47 | et Casing diameter: | 16inches Type of casing: | PVC | | |
| casing tength. 20 | Screen diameter: | 16 inches Type of screen: | PVC | | |
| Screen length: | inches | th: From 47feet to 67 | feet | | |
| | | cked Underreamed 10pen hole N | atural Development | | |
| Other (describe): | | | REULI | | |
| Top of lap pipe or reduction | in casing:fee | et . | NOV 3 0 2020 | | |
| | If telescoped or more that | nn one screen, describe on next page | E OLIVIO GMB 13 MA | | |

STATE OF MISSISSIPPI

Department of Environmental Quality Office of Land and Water Resources P.O.Box 2309 Jackson, Mississippi 39225

PERMIT TO DIVERT OR WITHDRAW FOR BENEFICIAL USE THE PUBLIC WATERS

This permit is issued to the landowner named below in accordance with the provisions of the Mississippi Water Laws, Mississippi Code Sections 51-3-1, et seq.(1972, as amended), and the regulations and standards as promulgated thereunder. Whether or not specifically named in this permit or in the applications for this permit, anyone using water from the diversion/withdrawal point described below shall do so in compliance with the provisions of this permit. Neither this permit, nor any authority conferred hereby, may be sold, conveyed, encumbered, assigned or otherwise aliened, for any period of time or under any conditions whatsoever. This permit may not be modified, transferred, or revoked without prior action by the Permit Board. Any altempts to modify, transfer or revoke this permit, or to take any other action on this permit, shall be invalid and unenforceable and may result in immediate revocation or suspension of this permit. The holder of this permit shall at all times be responsible for adherence to the terms and conditions of this permit. No agreement between the permit holder and any other party shall affect the obligations and liabilities of the permit holder. Water use under this permit is allowed only when the streamflow or lake level elevation (whichever, if any, is applicable) is above the established minimum, pursuant to Mississippi Code Section 51-3-7. Authorization is hereby granted to divert/withdraw water for the beneficial use designated herein, and for no other purpose, subject to the following terms, conditions, and limitations

Permit Number:

MS-GW-51045

Total Permitted Acreage: 117

Landowner Name:

HARTZELL BROTHERS INC

Landowner Address:

7300 HWY 35 SOUTH

BATESVILLE, MS 38606

MISSISSIPPI RIVER VALLEY ALLUVIAL AQUIFER

Source of Water: Beneficial Use(s):

IRRIGATION

Diversion/Withdrawal Location: NE 1/4 of the SW 1/4

See Special Terms And Conditions (attachment 1)

Section: 29

Township: 27N

Range: 031:

County:

PANOLA

Quad:

TOCOWA

Permitted Acreage:

Irrigation: 117

Wildlife Management: 0

Maximum Volume:

Fish Culture: 0

Applicant Name: Applicant Address: VAUGHN, RYAN 217 HICKORY LANE

BATESVILLE, MS 38606

Date Permit Issued:

12/26/2019

Date Permit Expires:

12/26/2024

Date Permit Modified:

Date Permit Reissued:

This permit shall be deemed null and void if construction has not begun within one (1) year of the permit issue date.


SPECIAL TERMS AND CONDITIONS 1:

See Attachment I which is hereby declared part of this permit.

Gary C. Rikard/Executive Director

Mississippi Department of Environmental Quality

| Permit #: GW-51045 | | | | |
|---|--|--|--------------------|-------------|
| P | Z AA | Well #: | | - |
| | required for water wells | Description of formations encountered | d must be provided | for all we |
| | | and borcholes, unless specifically exer | npted by regulatio | ns |
| f well telescopes, show | depths on sketch. | Description of Formations Encountered | From (depth) | To (depth) |
| Fround Level | | Description of Formations Encountered | Ground level | 10 (00) |
| 2 | CASING | CLAY | 10 | 20 |
| 20 | CASING | MEDIUM SAND & PEA & GRAVEL | 20 | 30 |
| 20 | CASING | MEDIUM SAND | 30 | 40 |
| 20 | SCREEN | MEDIUM SAND & PEA & GRAVEL | 40 | 50 |
| 5 | CASING | MEDIUM SAND & PEA & GRAVEL | 50 | 60 |
| | Gronto | CLAY | 60 | 65 |
| | | | | |
| | | | | |
| the well location any permanent structure | and include the following: ctures on the property that may les, or other items that may aid | aid in locating the well in locating the property and the well | | |
| the well location any permanent struct any roads, power lin | and include the following: | aid in locating the well in locating the property and the well | RECE NOV 30 | |
| the well location any permanent struct any roads, power lin | and include the following: | aid in locating the well in locating the property and the well | | |
| 1) the well location 2) any permanent struct 3) any roads, power lin 4) north arrow andowner Name: | and include the following: ctures on the property that may nes, or other items that may aid | in locating the property and the well | NOV 30 BY OL | 2020 .WR |
| 1) the well location 2) any permanent struc 3) any roads, power lin 4) north arrow | and include the following: ctures on the property that may nes, or other items that may aid | aid in locating the well in locating the property and the well in locating the property and the well in locating the well in loc | NOV 30 BY OL | 2020 WR |
| andowner Name: HEREBY CERTIFY that the Equirements of the Miss applicable, and state to the Martox | and include the following: ctures on the property that may nes, or other items that may aid | in locating the property and the well | NOV 30 BY OL | 2020 WR |
| 1) the well location 2) any permanent struc 3) any roads, power lin 4) north arrow | and include the following: ctures on the property that may nes, or other items that may aid | in locating the property and the well | NOV 30 BY OL | 2020 W F |

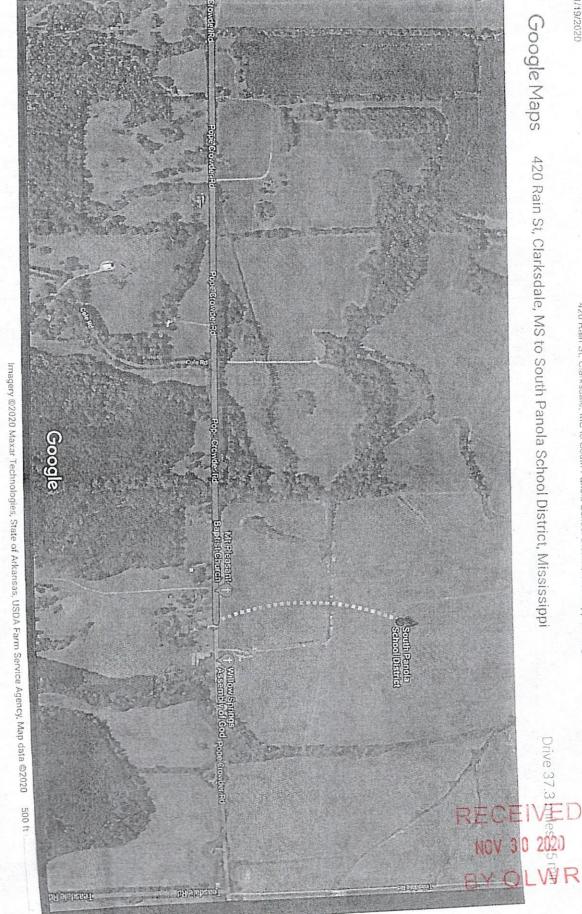

37.3 miles 45 min

D

via MS-322 E

Fastest route

via Sabino Rd and MS-322 E

D

46 min

omle com/mans/dir/420+Rain+St.+Clarksdale.+MS/34+10+45N+90+00+35W+/@34.1752928.-90.014866.1447m/data=i3m111e3j4m1114m10j1m5j1m1j1s0x862ade4e7t594b05:0x5e139e...

STATE WELL REPORT

Part 2

PANOLA County: Permit #: GW-51045 Driller: CHAD MATTOX Date completed: Copy information from block on Part 1

Pump Installer's Completion Report Mississippi Department of Environmental Quality Office of Land and Water Resources P.O. Box 2309

Jackson, MS 39225-2309 (601)961-5210 (601) 360-0535 (fax)

| For (| Office | Use | Only: |
|----------|--------|-----|-------|
| Well #: | U | 10 | 8 |
| Aquifer: | | | |

This part of the report must be completed by a licensed water well contractor or a licensed pump installer. A copy of Part 1

| of the report must be attached and both parts filed with the l | Department at the above address within 30 days of well completion. | | | |
|---|--|--|--|--|
| Well Owner Information | Well Location | | | |
| Owner Name: HARTZELL BROTHERS INC | Latitude: 34 10 45N Longitude: 90 00 35W | | | |
| Mailing Address: | Method of Lat/Long (select one): Conventional Survey | | | |
| 7300 HWY 35 SOUTH | | | | |
| | USGS quad O, Hand-held GPS O, Survey-grade GPS O | | | |
| BATESVILLE MS 38606 City State Zip Code | NE ¼ SW ¼, Sec_29 T_27N R_03E | | | |
| | Miles of (Distance) (Direction) (Nearest Town) | | | |
| Telephone No. () | (Distance) (Direction) (Nearest Town) | | | |
| Pump Ty | pe (select one) | | | |
| O Submersible Turbine OAir Lift O Centrifugal O Flowing We | ell O Jet O PistonO RotaryOOther (describe): | | | |
| | Rated Pump Capacity:Gallons Per Minute | | | |
| | | | | |
| Is This Pump (select one): New O Repaired O Replaceme | nt pe (select one) | | | |
| | | | | |
| O Electric Diesel O Gasoline O Natural Gas O Tractor PTO C | OWindmill O Other (describe): | | | |
| Horse Power Rating of Motor: Setting Dep | th:feet Number of Stages: 2 | | | |
| Pump Test Data | for Non Flowing Well | | | |
| | | | | |
| Date Well Tested: Duration of Pump Test (minimum 4 hours): hours Static Water Level (A): 22 Feet Below Land Surface Pumping Water Level (B): Feet Below Land Surface | | | | |
| Drawdows (A). | Pumping water Level (B): Feet Below Land Surface | | | |
| | face Test Pumping Rate: Gallons Per Minute | | | |
| Method of measurement (select one): • Steel tape • Electrone | | | | |
| [1922년 1925년 전 : 10 Telephone (1925년 1927년 1927년) 12 12 12 12 12 12 12 12 12 12 12 12 12 | ta for Flowing Well | | | |
| Measured shut in head:feet. | | | | |
| Well yieldedGPM with a drawdown of | feet afterhours of pumping | | | |
| Meter | Installation | | | |
| Meter Manufacturer: | Meter Serial Number: | | | |
| Meter Model Number/Name: Type of Meter: RECEIVED | | | | |
| Totalizer Register Unit and Multiplier Factor (AF x .001, gal x 1000, etc): | | | | |
| Installation Date: Meter installed by: | | | | |
| Is This Meter (circle one): O New O Repaired O Replacement | | | | |
| Important: By submitting the above information you are certifying that this meter was installed to manufacturer standards. For agricultural wells, a list of approved meters is on the MDEQ website. | | | | |
| I HEREBY CERTIFY that the above statements are true to the best of my knowledge. | | | | |
| David P. Holt 0-752P | (Do 11 M | | | |
| Print Name of Pump Installer and License No. (if applicable) | Date Signature of Pump Installer | | | |

Form: OLWR-SWR-2A (4/13)