

PANOLA
 U-2000
 3-22-76

MISSISSIPPI
 BOARD OF WATER COMMISSIONERS
 416 North State Street
 Jackson, Mississippi 39201

15F WATER WELL DRILLERS LOG

3-22-76 19 26 Lipe Well Co. Panola

date well completed

firm name

county well located

LANDOWNER:

C. G. Tower &

POPE MS,
 (mailing address)

description of formations encountered

from to

red sand

0 20

ll ll
 white clay
 sand

20 40

40 60

60 80

ll

80 100

sand and clay

100 120

sand

120 151

WELL LOCATION:


sec. 34 T 27 S R 62 E
 6 miles East of POPE
 (distance) (direction) (nearest town)

WELL PURPOSE:

(home, irrigation, municipal, industrial)

WELL COMPLETION DATA:

- (1) diameter (inches) 4
- (2) total depth (feet) 151
- (3) static water level (feet) 90 below above top of ground.
- (4) casing PVC 141
 (material) (depth)
 4 (size) If telescope see back.
- (5) screen 10 141
 (length) (depth to top)
 4 PVC
 (size) (material)
- (6) pump 3/4 10
 (HP) (yield gpm)
 elec.
 (type power)
- (7) electric log no.
 (yes or no)
 no
 (organization running log)
- (8) how well bottom plugged PVC
 CAP

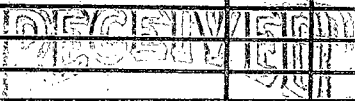


MAR 29 1976

DRILLERS REMARKS:

If well telescopes please sketch and show depths.

GROUND LEVEL

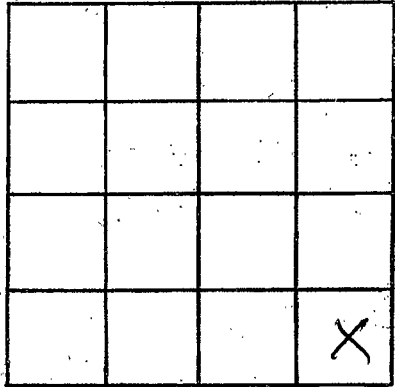

SECTION 34

Please indicate well location X.

ADDITIONAL INFORMATION

If more than one screen,
show locations of each on sketch.