

PANOLA

7, 11-2001

3-23-76

MISSISSIPPI
 BOARD OF WATER COMMISSIONERS
 416 North State Street
 15F Jackson, Mississippi 39201

WATER WELL DRILLERS LOG

3-23

1976 Life Well Co.

Panola

date well completed

firm name

county well located

LANDOWNER:

Joe Sutton

Pope Miss.

(mailing address)

description of formations encountered

Top Soil

sand

ll

sand and clay

sand

from

to

0 20

20 40

40 60

60 80

80 120

WELL LOCATION:

sec. 29 T. 27 N. R. 3 E. S. 3 W.


3 miles south of Pope (distance) (direction) (nearest town)

WELL PURPOSE:

(home irrigation, municipal, industrial)

WELL COMPLETION DATA:

- (1) diameter (inches) 4
- (2) total depth (feet) 120
- (3) static water level (feet) 60 below above top of ground.
- (4) casing PVC 110 (material) (depth)
- 4 (size) if telescope see back.
- (5) screen 10 110 (length) (depth to top)
- 4 (size) PVC (material)
- (6) pump 3/4 10 (HP) (yield gpm)
- elec. (type power)
- (7) electric log no (yes or no)
- no (organization running log)
- (8) how well bottom plugged PVC CAP

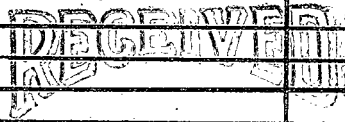


MAR 29 1976

DRILLERS REMARKS:

If well telescopes please sketch and show depths.

GROUND LEVEL

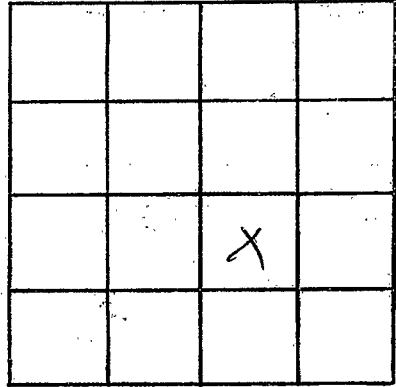

SECTION 29

Please indicate well location X.

ADDITIONAL INFORMATION

If more than one screen,
show locations of each on sketch.