

Panola
U-2003
3-1-77

MISSISSIPPI
 BOARD OF WATER COMMISSIONERS
 416 North State Street
 Jackson, Mississippi 39201

15F

WATER WELL DRILLERS LOG

3-1 1977 Harris Bros Panola
 date well completed firm name county well located

LANDOWNER Calvert Brown
At. 2 Box 165
Batesville
 (mailing address)

description of formations encountered	from	to
<u>top soil</u>	<u>0</u>	<u>1.5</u>
<u>fine blue sand</u>	<u>1.5</u>	<u>7.5</u>
<u>coarse sand</u>	<u>7.5</u>	<u>100</u>

WELL LOCATION:
 sec. 24 T. 27 N. R. 2 E.
2 1/2 miles NE of Cramer
 (distance) (direction) (nearest town)

WELL PURPOSE: Industrial
 (home, irrigation, municipal, industrial)

WELL COMPLETION DATA:

(1) diameter (inches) 4"

(2) total depth (feet) 100

(3) static water level (feet) 40 below top of ground.

(4) casing Plastic, 86
 (material) (depth)

4 if telescope see back.
 (size)

(5) screen 14, 86
 (length) (depth to top)

008, Plastic
 (size) (material)

(6) pump 2, 30
 (HP) (yield gpm)

elec.
 (type power)

(7) electric log no
 (yes or no)

(organization running log)

(8) how well bottom plugged solid


DRILLERS REMARKS:

RECEIVED
 MAY 26 1977

MISS. BO. OF WATER COMM.

If well telescopes please sketch and show depths.

GROUND LEVEL

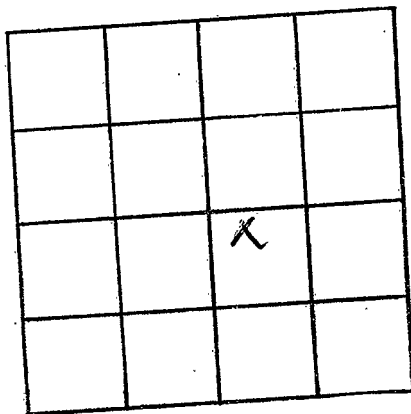

SECTION 24

Please indicate well location X.

ADDITIONAL INFORMATION

If more than one screen, show locations of each on sketch.