

PANOLA  
 U-2004  
 3-28-77

MISSISSIPPI  
 BOARD OF WATER COMMISSIONERS  
 416 North State Street  
 Jackson, Mississippi 39201

WATER WELL DRILLERS LOG

3-28 1977 <sup>15F</sup> Harold Bros. Panola  
 date well completed firm name county well located

LANDOWNER: Wilburn Cannon  
 Rt. 2  
 Batesville  
 (mailing address)

description of formations encountered	from	to
top soil	0	15
fine blue sand	15	75
coarse white sand	75	100

WELL LOCATION:  
 sec. 24 T 27 N R 2 E  
 2 1/2 miles NE of Crowder  
 (distance) (direction) (nearest town)

WELL PURPOSE: Industrial  
 (home, irrigation, municipal, industrial)

- WELL COMPLETION DATA:
- (1) diameter (inches) 4
  - (2) total depth (feet) 100
  - (3) static water level (feet) 40 <sup>below</sup> top of ground. <sub>above</sub>
  - (4) casing Plastic, 86  
 (material) (depth)  
 4 If telescope see back.  
 (size)
  - (5) screen 14, 86  
 (length) (depth to top)  
 008, Plastic  
 (size) (material)
  - (6) pump 2, 30  
 (HP) (yield gpm)  
 elec.  
 (type power)
  - (7) electric log no  
 (yes or no)
- (organization running log)
- (8) how well bottom plugged solid


DRILLERS REMARKS:

RECEIVED  
 MAY 26 1971

MISS. BD. OF WATER COMM

If well telescopes please sketch and show depths.

GROUND LEVEL

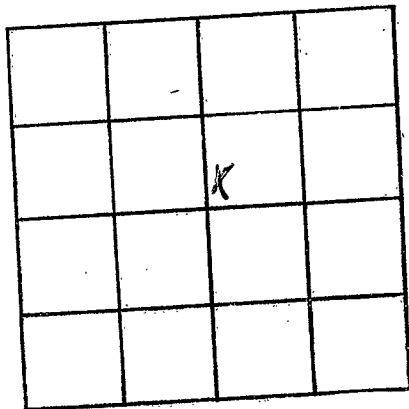

SECTION 24

Please indicate well location X.

ADDITIONAL INFORMATION

If more than one screen,  
show locations of each on sketch.