

PANOLA
 U-2005
 7-15-77

MISSISSIPPI
 BOARD OF WATER COMMISSIONERS
 416 North State Street
 Jackson, Mississippi 39201

WATER WELL DRILLERS LOG

July 15 1977 Lipe Well Co. Panola
 date well completed firm name county well located

LANDOWNER:
 Billy Vaughn
 Crowder Ms.
 (mailing address)

description of formations encountered	from	to
Top soil	0	20
Gravel	20	40
Gravel and sand	40	80
sand	80	100
Clay	100	120
"	120	140
"	140	160
sand	160	180

WELL LOCATION:
 sec. 15 T 10 N R 2 E S 3
 2¹/₂ miles NE of Crowder
 (distance) (direction) (nearest town)

WELL PURPOSE:
 (home, irrigation, municipal, industrial)

- WELL COMPLETION DATA:
- (1) diameter (inches) 4
 - (2) total depth (feet) 180
 - (3) static water level (feet) 90 below top of ground.
 - (4) casing PVC 170 (material) (depth)
 4 (size) If telescope see back.
 - (5) screen 10 170 (length) (depth to top)
 4 PVC (size) (material)
 - (6) pump 3/4 10 (HP) (yield gpm).
 elec. (type power)
 - (7) electric log NO (yes or no)
 NO (organization running log)
 - (8) how well bottom plugged PVC cap


DRILLERS REMARKS:

RECEIVED
 AUG 1 1977

MISS. RD. OF WATER COMMISSIONERS

If well telescopes please sketch and show depths.

GROUND LEVEL

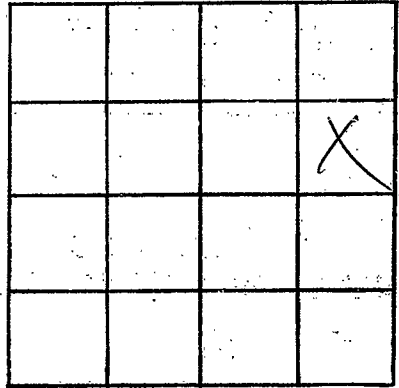

SECTION 15

Please indicate well location X.

ADDITIONAL INFORMATION

If more than one screen, show locations of each on sketch.